

Role	Name	Mobile	Phone	Email
Leasing Contact	Damon Smith	0408 395 900		damon@verimark.com.au
Designer	Joel Chuah	0423 396 523	02 8068 1755	joel@liteco.com.au

Scentre Group Contacts

Role	Name	Mobile	Phone	Email
Retail Delivery Coordinator	Todd Williams	0407260118		twilliams@scentregroup.com
Retail Design Manager	Lana Munro	0409400804		lmunro@scentregroup.com
Team Coordinator	Laura Ellis		02 9901 6885	lellis@scentregroup.com
Retail Administrator	Meher Dangore			mdangore@scentregroup.com
Leasing Executive	Jack Holliday			jholliday@scentregroup.com
Special Projects Coordinator	Andrew Hoy			ahoy@scentregroup.com
Facilities Manager	Tim Parker			tparker@scentregroup.com
Facilities Manager	Greg Hamilton			ghamilton@scentregroup.com
Facilities Manager	Kane Hart			khart@scentregroup.com

Certification Required Upon Completion of Lessee’s Works and Prior to Trade

Lessee Certificate

- Building Authority Approval
- Occupation Certificate
- Plumbing and Gas Installation Certificate
- Structural Design and Installation Certificate
- Waterproof Membrane Certificate
- Electrical Certificate

Lessor Certificate

- Fire Safety Certification

Outstanding info to be provided to Scentre Grp prior to commencing work on site

- The Building Permit.
- Full colour graphic design package, for separate approval by Scentre Group and prior to manufacture.

Lessor Work at Lessee Cost

There are changes to the Lessor Works scope from the preceding Issue as follows :
Existing structure to be removed

General Notes

Existing structure to be removed, all new kiosk

Electrical

- Install EDB to suit Lessee’s fitout design
- EDB location as shown.

Mechanical Ventilation Systems

N/A

Plumbing and Drainage

As shown

Other Works

- Core hole drilling required, refer to Lessee’s core hole set-out drawing

SCENTRE GROUP		APPROVED DESIGN CONCEPT	
DATE:	17/09/2020	VERSION:	2
WESTFIELD:	Warringah Mall		
SHOP:	25K1		
RETAIL DESIGN MANAGER:	Lana Munro		
Consent of the concept is granted to the lessee for the shopfront, shop layout and signage shown in these plans. Scentre Group notations including comments and handwritten changes must be complied with.			
ENGINEER'S CERTIFICATE REQUIRED TO VERIFY STRUCTURAL ADEQUACY. SHOPFITTERS MUST KEEP A COPY OF THESE SCENTRE GROUP STAMPED DRAWINGS ON SITE AT ALL TIMES. (DESTROY ALL PREVIOUS ISSUES AND ALL UNSTAMPED DRAWINGS)			

BUILDING CODE
The Lessee must comply with the requirements of the Building Code of Australia including with limitation the conditions of the fire engineered design solution for the Centre/Development

WESTFIELD WARRINGAH MALL KIOSK 25K1


Revised drawings showing no structure.
Pylon sign structures to be included in final
engineers SDIC inspection as required.

ISSUE NO	1	2	3	4					
PURPOSE OF ISSUE	DESIGN APPROVAL	DESIGN APPROVAL	DESIGN APPROVAL	DESIGN APPROVAL					
DATE	30.07.2020	24.08.2020	02.09.2020	11.09.2020					

Drawing No	Current Revision	Drawing Title	Revision Status								
0000	A	Issue Sheet	A		B	C					
0001	A	Cover Page	A								
0002	A	Front Perspective 1	A	B	C	D					
0003	A	Front Perspective 2	A	B	C	D					
0004	A	Side Perspective 1	A	B	B	D					
0005	A	Side Perspective 2	A	B		C					
0006	A	Rear Perspective	A	B		C					
0007	A	Equipment Schedule	A	B	C						
0008	A	Material Schedule	A	B							
0100	A	Site Plan	A								
0101	A	Demolition Plan	A	B		C					
0102	A	Layout Plan	A	B	C	D					
0103	A	Dimension Plan	A	B	C	D					
0104	A	Finishes Plan	A	B	C	D					
0105	A	Electrical & Hydraulic Plan	A	B	C	D					
0106	A	Reflected Ceiling Plan	A	B		C					
0200	A	Front Elevation	A	B	C	D					
0201	A	Rear Elevation	A	B		C					
0202	A	Side Elevation	A	B	C	D					
0203	A	Side Elevation 2	A	B	C	D					

ISSUE NO	1	2	3	4					
PURPOSE OF ISSUE	DESIGN APPROVAL	DESIGN APPROVAL	DESIGN APPROVAL	DESIGN APPROVAL					
DATE	30.07.2020	24.08.2020	02.09.2020	11.09.2020					

[illegible]

<div></div> <div>suite 42, Level 7, 591 George St, Sydney P (+61 2) 8068 1755 F (+61 2) 9264 8787 joel@liteco.com.au</div>	CLIENT YOGURT BERRY	<div>NOTES</div> <ul style="list-style-type: none">• All drawings to be read in conjunction with all engineers documentation and specification.• Contractor to ensure all new building works, new fittings and fixtures are installed to the current BCA, Australian Standards and Work Cover Regulations.• The Contractor shall use figured dimensions in preference to scaled dimensions. All dimensions shall be verified on site by the Contractors prior to commencing any work or preparing shop drawings.• All materials are to be used in accordance with manufacturer's specifications and instructions, and to comply with relevant Australian Standards.• Partition set-out to be approved by Project Manager on-site prior to construction.• COPYRIGHT These drawings and the designs are the property of Liteco project and must not be used, retained or copied without written permission of Liteco project.					TITLE	DRAWING NO.			
	PROJECT WESTFIELD WARRINGAH MALL MALL KIOSK 25K1		C	11.09.2020	JC	DESIGN APPROVAL	ISSUE SHEET	0000			
			B	02.09.2020	JC	DESIGN APPROVAL		SCALE	NA@ A3		
			A	30.07.2020	JC	DESIGN APPROVAL		DRAWN BY	JC	CHECKED	JC
			ISSUE	DATE	INITIALS	REVISION DETAIL		CLIENT APPROVAL	ISSUE	C	

GENERAL CONDITIONS

RESPONSIBILITY

The contractor is responsible for all works under the contract. The contractor agrees to carry out and complete the works by the practical completion date

The contractor :

- Shall comply with all laws that are relevant to the conduct of workd, including any laws relating to the environment, and play any fees in respect of complying with all laws
- Will obtain all Authority approvals (excluding Council DA and construction certificate) necessary for the conduct of the works, and pay any fees in respect of those approvals, before the commencement of the works or relevant part of the work
- Obtain landlord & body corporate approvals for any work affecting other tenancies as a result of the works
- In carrying out the works, comply with all relevant Australian Standards, environmental standard and industry codes, including any construction or operating standards advised by FHC, the OHS act and work cover requirements
- Shall take all necessary measure to protect people and property at or near the site and perform the works in such a way as to minimize all noise, disturbance and inconvenience to FHC and its neighbor tenants, its representative and any other occupier of the site or in the vicinity of the site
- Shall immediately notify the client and design project manages of any damage to the site during the course of work. The appropriate repair and action to the approval of the project manager shall be undertaken by the contractor

DIMENSION

The contractor is to verify all dimension figured on the drawings by actual site measurement. Any discrepancy with the figural dimension on plan must be immediately drawn to the attention of Liteco Studio

LIMITATION OF WORK, RESTRICTION & SPECIAL REQUIREMENTS

- Work operation, storage of materials, location of plant and equipment and material are to be confined to the site
- All core hole drilling requires the certification from a certified structural engineer
- Storage of all material is to be contained to the site
- No site parking is available other than for deliveries as determined by the landlord management
- All rubbish and garbage is to be removed by the head contractor
- Every contractor must register with the security and the site foreman/construction manager on entry and exit from the site
- Dilapidation report and survey is to be carried out with the project manager at the start of the project

SUPERVISION & SITE MEETINGS

- The Contractor is to accept responsibility for co-ordination and administration of the work, including all sub contractor and independent contracts. Arrange and monitor a programme with each other contractor supplier, local authority and statutory undertaker, and obtain and supply information as necessary for coordination of the work

VARIATION

No variation of any kind will be allowed or paid for unless a written order or instruction signed by Liteco Studio and the client. All variation must be made in writing to Liteco Studio and approved prior to the works commencing on or off the site. The cost of the variation is to be agreed upon before the work is put in hand

STANDARD SPECIFICATION MATERIAL & WORKMANSHIP

Where reference is made to Standards Association of Australia (SAA) & Standard Specification (AS), shall apply to the relevant materials or operation and be deemed to be incorporated and be deemed to be incorporated in this specification

The contractor shall obtain and on Final completion surrender to the project manager all necessary approvals and certificates issued by the authorities

All samples of timber are to be submitted to Liteco Studio for approval before use in the building

All work shall be carried out in through workman line manner by skilled tradesman only, and any work not executed to a high standard of finish will be rejected by the project manager and shall be replaced or redone by the contractor at his own expense

No substitution or specified material is to be made without approval of Liteco Studio

FOREMAN, SITE SUPERVISION & CONSTRUCTION MANAGEMENT

The contractor is to employ a thoroughly competent foreman/ construction manager or site supervisor for the sole purpose of carrying out the whole of the work, and the project manager reserves the right to insist on a change if not satisfied

The foreman is to be employed for the duration of the project and is to be single point of contact with the project manager, client, contractor and suppliers on the site. The foreman or construction manager is responsible for the site and all trades excluding furniture suppliers

OTHER RESPONSIBILITIES INCLUDE BUT NOT LIMITED TO

- Site deliveries acceptance and supervision
- Site rubbish removal supervision
- Site supervision of all of out of hours work including below floor tenancies as outlined in the contract specification and drawings
- Site inductions of all trades
- Site supervision of all occupational health and safety procedures
- Site supervision of contractor risk management of all trades
- Site supervision or emergency procedures
- Site fire warden and first aid responsibilities as per the NSW OHS act and landlord rules and regulation
- Hold a current St John Ambulance or equally approved senior first aid certificate

EXISTING SERVICES

The contractor shall obtain information on the location and depth of any services, which exists on the site including those not shown on the drawings

The contractor shall exercise the greatest care during the progress of the work to avoid damage to any utilities service including gas, water, sewer, electric power, telephone etc, within the limit of the work and still be held responsible for any such damage caused by the contractor or agents of the contractor directly or indirectly

Adhere to all authorities recommendation

Replace any marker tapes or concealed, the contractor is to clearly mark in an unobtristive manner to the approval of the project manager

The use of services shall be in accordance with OH&S and workcover guideline

COMMUNICATION

The head contractor must be contactable all the times during the course of the project. The head contractor must maintain mobile & email services on site

COMPLETION

Before the issue of the certificate of practical completion, the contractor shall arrange to

- clean all floors and window
- ease and oil locks and similar working parts
- remove all stains and dropping of paint and mortar
- label and hand over all keys numbered and tagged
- test all services, fixtures and equipment
- leave the project clean, tidy and fit for use or occupancy by the client
- provide information for warranties and guarantees of services and fittings
- obtain and issue all services maintenance manuals, certificates of compliance

The contractor shall ensure that any defects found in the project prior to final completion are expeditiously remedied, provided such defects are not due to normal wear and tear or acts by other outside the control of the contractor after the date of practical completion

Defects: the contractor is responsible for completing all defects prior to informing the project manager or practical completion

CONSTRUCTION PROGRAMME

A full detailed construction program for each construction period scenario shall be submitted within 1 week from appointment and shall allow public holiday, coordination of activities and their relationship, external dependencies such as approvals and material deliveries, the sequence of events which map out a critical path, services installation, demolition and strip out. The contractor shall provide an updated programme at weekly intervals during the course of the project in microsoft project of software approved by project manager

AUTHORITIES APPROVALS & DOCUMENTATION ON THE SITE

The appointed head contractor is to keep a full set of the current issue of all contract documents and copy of Development and Construction Certificate approvals and condition on site during the entire course of the project including architectural drawings, services drawing and all specification

INTENT OF SPECIFICATION & DRAWINGS

The work to be provided under this contract documentation comprises the design, supply, delivery, installation,commissioning testing, and warranty of the works as listed in the specification and all associated drawings

PERFORMANCE

The head contractor is to allow for full design, supply, delivery, installation, commissioning, testing and the warranty of the works in line with the documentation and client requirements. By accepting the contract, the contractor shall deemed to have have guaranteed that the installation shall meet the performance requirement of this specification, the proposed approved design and client requirement

DEFECTIVE WORK

- The contractor shall, at his own expense, reconstruct, alter, replace the works or supply the material and plant in accordance with the approved design when
- any work are deemed to be defective
 - any material or plant is inferior in quality or performance

SAMPLES

Where required the contractor shall submit identified samples of any materials or items to be used on the project. All work not conforming to the approved samples will be rejected and replaced

CODES & AUTHORITIES

- The installation of the proposed systems as required executing the contract works shall comply with the requirement of all relevant codes and authorities having jurisdiction and specifically with the following:
- building code of Australia (BCA)
 - AS 1668 part 1 (Fire and Smoke Control) and part 2 (Ventilation)
 - AS 2107 (Acoustic)
 - AS 3000 (SAA Wiring Rules)
 - Sydney Water
 - NSW Health Act
 - HB40-1922 Code of Good Practice
 - CFC's/NSW Ozone Act and Legislation
 - Council & Private Certifier condition of Development and Construction Certificate Approval
 - Fire brigade, Board of Fire Commission
 - AS 1288.1-2006, AS 2047 and AS 1170.1 Glazing (including decals)
 - All floor, wall and ceiling materials and lining will have fire hazard properties complying with specification C1.10 & C1.10a of the BCA as applicable
 - All doors handle, locks and fail safe devices will comply with clause D2.21 of the BCA
 - All automatic (power operated) doors will comply with D2.19 of the BCA
 - All exits and path of travel to an exit from any point on the floor, including the minimum unobstructed width of any path of travel to exits, will comply with D1.6 of the BCA
 - Balustrade and handrails will comply with BCA clause D2.16 to D2.18 and AS 1170
 - Fire Hose Reel (FHR) & Fire Hydrant (FH) coverage as a result of the proposed works will comply with relevant BCA requirement
 - Disabled access, facilities & circulation space will comply with Part D3 of the BCA & AS 1428.4
 - Artificial lighting not to exceed the maximum illumination power density specified under clause J6.2(b) & Table J6.2a as applicable
 - Artificial lighting for all rooms or space on a floor must be individually operated by a switch or other control device in accordance with J6.3(e) of the BCA
 - All requirement essential fire safety measures will be provided or adjusted (where appropriate) to comply with the base building fire safety schedule and alternative solution requirement, unless otherwise altered in the fire safety schedule issued with CC/CDC approval for the proposal work. Refer to Fire Safety Schedule (or Annual Fire Safety statement) issued for the base building and the CC/CDC issued for the proposed work

FOOD PREMISES CODE & AUTHORITIES


Contractor to ensure all construction has been checked to comply with the requirement of:

- The relevant provisions of the Building Code of Australia relating to: mechanical ventilation, and the position of all proposed air intake and discharge points relative to the amenity of the neighborhood, and toilet and other sanity facilities for patrons and staff
- AS 4674-2004 design, construction and fitout of food premises
- FSANZ food standard code
- The food act 2003
- The food regulation 2004
- The minimisation of likely conamination of food and the provision of temperature control as required by the food regulation
- Council Code for Waste Handling in building
- All relevant DA consent conditions


No substitution or specified material is to be made without approval of Liteco Studio										including architectural drawings, services drawing and all specification									
<div>SCENTRE GROUP</div> <div>APPROVED DESIGN CONCEPT</div>																			
<div>DATE: 17/09/2020</div> <div>LOCATION: 3</div>																			
<div>WESTFIELD SHOP: 25K1</div> <div>CLIENT: YOGURT BERRY</div>																			
<div>RETAIL DESIGN MANAGER: Lana Munro</div>																			
<div>Consent of this concept is granted to the lessee for the shopfront, shop layout and signage shown in these plans. Scentre Group notations including comments and handwritten changes must be complied with. PROJECT: WESTFIELD WARRINGAH MALL KIOSK 25K1</div>																			
<div>adequacy. SHOPFITTERS MUST KEEP A COPY OF THESE SCENTRE GROUP STAMPED DRAWINGS ON SITE AT ALL TIMES. (DESTROY ALL PREVIOUS ISSUES AND ALL UNSTAMPED DRAWINGS)</div>																			
<div>NOTES</div> <ul style="list-style-type: none">All drawings to be read in conjunction with all engineers documentation and specification.Contractor to ensure all new building works, new fittings and fixtures are installed to the current BCA, Australian Standards and Work Cover Regulations.The Contractor shall use figured dimensions in preference to scaled dimensions. All dimensions shall be verified on site by the Contractors prior to commencing any work or preparing shop drawings.All materials are to be used in accordance with manufacturer's specifications and instructions, and to comply with relevant Australian Standards.Partition set-out to be approved by Project Manager on-site prior to construction.COPYRIGHT These drawings and the designs are the property of Liteco project and must not be used, retained or copied without written permission of Liteco project.																			



SCENTRE GROUP		APPROVED DESIGN CONCEPT	
DATE:	17/09/2020	VERSION: 2	
WESTFIELD:	Warringah Mall		
SHOP:	2SK1		
RETAIL DESIGN MANAGER:	Lana Munro		
Consent of the concept is granted to the lessee for the shopfront, shop layout and signage shown in these plans. Scentre Group notations including comments and handwritten changes must be complied with.			
ENGINEER'S CERTIFICATE REQUIRED TO VERIFY STRUCTURAL ADEQUACY. SHOPFITTERS MUST KEEP A COPY OF THESE SCENTRE GROUP STAMPED DRAWINGS ON SITE AT ALL TIMES. (DESTROY ALL PREVIOUS ISSUES AND ALL UNSTAMPED DRAWINGS)			

<div></div> <div>suite 42, Level 7, 591 George St, Sydney P (+61 2) 8068 1755 F (+61 2) 9264 8787 joel@liteco.com.au</div>	CLIENT YOGURTBERRY	<div>NOTES</div> <ul style="list-style-type: none">• All drawings to be read in conjunction with all engineers documentation and specification.• Contractor to ensure all new building works, new fittings and fixtures are installed to the current BCA, Australian Standards and Work Cover Regulations.• The Contractor shall use figured dimensions in preference to scaled dimensions. All dimensions shall be verified on site by the Contractors prior to commencing any work or preparing shop drawings.• All materials are to be used in accordance with manufacturer's specifications and instructions, and to comply with relevant Australian Standards.• Partition set-out to be approved by Project Manager on-site prior to construction.• COPYRIGHT These drawings and the designs are the property of Liteco project and must not be used, retained or copied without written permission of Liteco project.	D	11.09.2020	JC	DESIGN APPROVAL	TITLE FRONT PERSPECTIVE 1	DRAWING NO. 0002	
	PROJECT WESTFIELD WARRINGAH MALL KIOSK 25K1		C	02.09.2020	JC	DESIGN APPROVAL			
			B	24.08.2020	JC	DESIGN APPROVAL		SCALE NA @ A3	
			A	30.07.2020	JC	DESIGN APPROVAL	DRAWN BY JC	CHECKED JC	
			ISSUE	DATE	INITIALS	REVISION DETAIL	CLIENT APPROVAL	ISSUE D	




<div></div> <div>suite 42, Level 7, 591 George St, Sydney P (+61 2) 8068 1755 F (+61 2) 9264 8787 joel@liteco.com.au</div>	CLIENT YOGURT BERRY	NOTES <ul style="list-style-type: none">• All drawings to be read in conjunction with all engineers documentation and specification.• Contractor to ensure all new building works, new fittings and fixtures are installed to the current BCA, Australian Standards and Work Cover Regulations.• The Contractor shall use figured dimensions in preference to scaled dimensions. All dimensions shall be verified on site by the Contractors prior to commencing any work or preparing shop drawings.• All materials are to be used in accordance with manufacturer's specifications and instructions, and to comply with relevant Australian Standards.• Partition set-out to be approved by Project Manager on-site prior to construction.• COPYRIGHT These drawings and the designs are the property of Liteco project and must not be used, retained or copied without written permission of Liteco project.	D	11.09.2020	JC	DESIGN APPROVAL	TITLE	DRAWING NO.	
	PROJECT WESTFIELD WARRINGAH MALL KIOSK 25K1		C	02.09.2020	JC	DESIGN APPROVAL	FRONT PERSPECTIVE 2	0003	
			B	24.08.2020	JC	DESIGN APPROVAL		SCALE	NA @ A3
			A	30.07.2020	JC	DESIGN APPROVAL		DRAWN BY JC	CHECKED JC
			ISSUE	DATE	INITIALS	REVISION DETAIL	CLIENT APPROVAL	ISSUE D	




SCENTRE GROUP	APPROVED DESIGN CONCEPT	
DATE:	17/09/2020	VERSION: 2
WESTFIELD:	Warringah Mall	
SHOP:	25K1	
RETAIL DESIGN	Lana Munro	
MANAGER:	Consent of the concept is granted to the lessee for the shopfront, shop layout and signage shown in these plans. Scentre Group notations including comments and handwritten changes must be complied with. ENGINEER'S CERTIFICATE REQUIRED TO VERIFY STRUCTURAL ADEQUACY. SHOPFITTERS MUST KEEP A COPY OF THESE SCENTRE GROUP STAMPED DRAWINGS ON SITE AT ALL TIMES. (DESTROY ALL PREVIOUS ISSUES AND ALL UNSTAMPED DRAWINGS)	

Menu artwork
required

<div><p>suite 42, Level 7, 591 George St, Sydney P (+61 2) 8068 1755 F (+61 2) 9264 8787 joel@liteco.com.au</p></div>	CLIENT YOGURTBERRY	<div>NOTES</div> <ul style="list-style-type: none">All drawings to be read in conjunction with all engineers documentation and specification.Contractor to ensure all new building works, new fittings and fixtures are installed to the current BCA, Australian Standards and Work Cover Regulations.The Contractor shall use figured dimensions in preference to scaled dimensions. All dimensions shall be verified on site by the Contractors prior to commencing any work or preparing shop drawings.All materials are to be used in accordance with manufacturer's specifications and instructions, and to comply with relevant Australian Standards.Partition set-out to be approved by Project Manager on-site prior to construction.COPYRIGHT These drawings and the designs are the property of Liteco project and must not be used, retained or copied without written permission of Liteco project.					TITLE	DRAWING NO. 0004
	PROJECT WESTFIELD WARRINGAH MALL KIOSK 25K1		C	11.09.2020	JC	DESIGN APPROVAL	SIDE PERSPECTIVE 1	
			B	02.09.2020	JC	DESIGN APPROVAL		SCALE NA @ A3
			A	30.07.2020	JC	DESIGN APPROVAL	DRAWN BY JC	CHECKED JC
			ISSUE	DATE	INITIALS	REVISION DETAIL	CLIENT APPROVAL	ISSUE C



SCENTRE GROUP		APPROVED DESIGN CONCEPT	
DATE:	17/09/2020	VERSION: 2	
WESTFIELD:	Warringah Mall		
SHOP:	25K1		
RETAIL DESIGN MANAGER:	Lana Munro		
Consent of the concept is granted to the lessee for the shopfront, shop layout and signage shown in these plans. Scentre Group notations including comments and handwritten changes must be complied with.			
ENGINEER'S CERTIFICATE REQUIRED TO VERIFY STRUCTURAL ADEQUACY. SHOPFITTERS MUST KEEP A COPY OF THESE SCENTRE GROUP STAMPED DRAWINGS ON SITE AT ALL TIMES. (DESTROY ALL PREVIOUS ISSUES AND ALL UNSTAMPED DRAWINGS)			

<div><p>suite 42, Level 7, 591 George St, Sydney P (+61 2) 8068 1755 F (+61 2) 9264 8787 joel@liteco.com.au</p></div>	CLIENT YOGURTBERRY	<div>NOTES</div> <ul style="list-style-type: none">• All drawings to be read in conjunction with all engineers documentation and specification.• Contractor to ensure all new building works, new fittings and fixtures are installed to the current BCA, Australian Standards and Work Cover Regulations.• The Contractor shall use figured dimensions in preference to scaled dimensions. All dimensions shall be verified on site by the Contractors prior to commencing any work or preparing shop drawings.• All materials are to be used in accordance with manufacturer's specifications and instructions, and to comply with relevant Australian Standards.• Partition set-out to be approved by Project Manager on-site prior to construction.• COPYRIGHT These drawings and the designs are the property of Liteco project and must not be used, retained or copied without written permission of Liteco project.					TITLE	DRAWING NO.
	PROJECT WESTFIELD WARRINGAH MALL KIOSK 25K1		C	11.09.2020	JC	DESIGN APPROVAL	SIDE PERSPECTIVE 2	0005
			B	24.08.2020	JC	DESIGN APPROVAL		SCALE NA @ A3
			A	30.07.2020	JC	DESIGN APPROVAL		CHECKED JC
			ISSUE	DATE	INITIALS	REVISION DETAIL		CLIENT APPROVAL



SCENTRE GROUP		APPROVED DESIGN CONCEPT	
DATE:	17/09/2020	VERSION: 2	
WESTFIELD:	Warringah Mall		
SHOP:	25K1		
RETAIL DESIGN MANAGER:	Lana Munro		
<p>Consent of the concept is granted to the lessee for the shopfront, shop layout and signage shown in these plans. Scentre Group notations including comments and handwritten changes must be complied with.</p> <p>ENGINEER'S CERTIFICATE REQUIRED TO VERIFY STRUCTURAL ADEQUACY. SHOPFITTERS MUST KEEP A COPY OF THESE SCENTRE GROUP STAMPED DRAWINGS ON SITE AT ALL TIMES. (DESTROY ALL PREVIOUS ISSUES AND ALL UNSTAMPED DRAWINGS)</p>			

SCENTRE GROUP

APPROVED DESIGN CONCEPT

DATE:

17/09/2020

VERSION: 2

WESTFIELD:

Warringah Mall

SHOP:

25K1


RETAIL DESIGN MANAGER:

Lana Munro


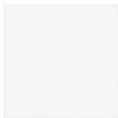



Consent of the concept is granted to the lessee for the shopfront, shop layout and signage shown in these plans. Scentre Group notations including comments and handwritten changes must be complied with.
ENGINEER'S CERTIFICATE REQUIRED TO VERIFY STRUCTURAL ADEQUACY. SHOPFITTERS MUST KEEP A COPY OF THESE SCENTRE GROUP STAMPED DRAWINGS ON SITE AT ALL TIMES. (DESTROY ALL PREVIOUS ISSUES AND ALL UNSTAMPED DRAWINGS)

NOTE:
ALL EQUIPMENT ARE TO BE CONFIRMED & APPROVE BY CLIENT

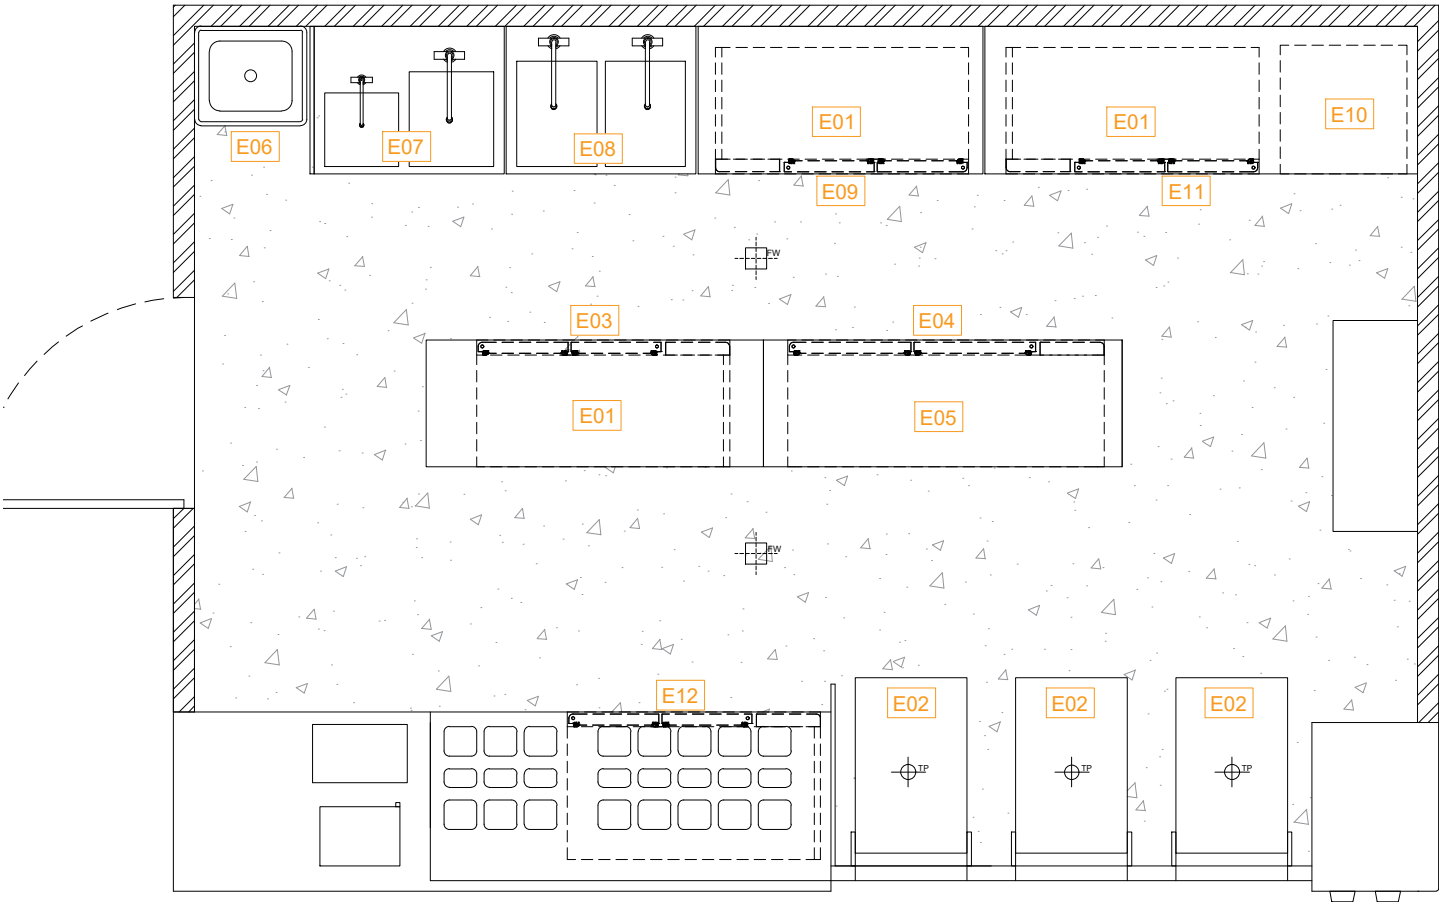
ITEM	DESCRIPTION OF ITEM	QTY	SUPPLIER	SIZE
E01	SUR12-2 UNDER COUNTER SOLID DOOR FRIDGE	3	SKIPIO	1200W x 600D x 855H
E02	YOGURTMACHINE	3	BY CLIENT	530W x 832D x 1500H
E03	MODULAR S/S WORK BENCH	1	BY BUILDER	1600W x 600D x 900H
E04	MODULAR S/S WORK BENCH	1	BY BUILDER	1700W x 600D x 900H
E05	SUR15-2 UNDER COUNTER SOLID DOOR FRIDGE	1	SKIPIO	1500W x 600D x 855H
E06	3 MONKEEZ AB-CS-L CLEANER SINK WITH BRACKET	1	BY BUILDER	532W x 472D x 480H
E07	HAND BASIN & PREP SINK S/S BENCH WITH DOOR (WITH SPLASHBACK)	1	BY BUILDER	900W x 700D x 900H
E08	DOUBLE SINK S/S BENCH WITH DOOR (WITH SPLASHBACK)	1	BY BUILDER	900W x 700D x 900H
E09	MODULAR S/S WORK BENCH (WITH SPLASHBACK)	1	BY BUILDER	1350W x 700D x 900H
E10	SCOTSMAN ECS 86 AS U/B ICE MAKER	1	BY BUILDER	531W x 600D x 825H
E11	MODULAR S/S WORK BENCH (WITH SPLASHBACK)	1	BY BUILDER	2050W x 700D x 900H
E12	UNDER BENCH TOPPING FRIDGE	1	BY CLIENT	



<div><div>LITECO STUDIO</div><div>suite 42, Level 7, 591 George St, Sydney P (+61 2) 8068 1755 F (+61 2) 9264 8787 joel@liteco.com.au</div></div>	CLIENT YOGURTBERRY	<div>NOTES</div> <ul style="list-style-type: none">All drawings to be read in conjunction with all engineers documentation and specification.Contractor to ensure all new building works, new fittings and fixtures are installed to the current BCA, Australian Standards and Work Cover Regulations.The Contractor shall use figured dimensions in preference to scaled dimensions. All dimensions shall be verified on site by the Contractors prior to commencing any work or preparing shop drawings.All materials are to be used in accordance with manufacturer's specifications and instructions, and to comply with relevant Australian Standards.Partition set-out to be approved by Project Manager on-site prior to construction.COPYRIGHT These drawings and the designs are the property of Liteco project and must not be used, retained or copied without written permission of Liteco project.				TITLE	DRAWING NO.
			C	02.09.2020	JC	DESIGN APPROVAL	0007
			B	27.08.2020	JC	DESIGN APPROVAL	SCALE NA @ A3
	PROJECT WESTFIELD WARRINGAH MALL KIOSK 25K1		A	30.07.2020	JC	DESIGN APPROVAL	CHECKED JC
			ISSUE	DATE	INITIALS	REVISION DETAIL	ISSUE C
						CLIENT APPROVAL	
						EQUIPMENT SCHEDULE	

CODE	ITEM	DESCRIPTION / FINISH	SUPPLIER	NOTE
F1		ALTRO STRONGHOLD ABYSS K3001 GENERAL FLOORING	ALTRO	ANY SUBSTITUTION MATERIAL TO BE APPROVED BY DESIGNER PRIOR CONSTRUCTION
T1		VOGUE SYSTEM GHIACCIO SATIN 100x100 PINK GROUT GENERAL WALL	CLASSIC CERAMIC	ANY SUBSTITUTION MATERIAL TO BE APPROVED BY DESIGNER PRIOR CONSTRUCTION
T2		VOGUE SYSTEM PERLA SATIN 100x100 PINK GROUT GENERAL WALL	CLASSIC CERAMIC	ANY SUBSTITUTION MATERIAL TO BE APPROVED BY DESIGNER PRIOR CONSTRUCTION
S1		HI-MACS SOLID SURFACE DIAMOND WHITE WHITE WALL & COUNTER TOP	BUILDER	ANY SUBSTITUTION MATERIAL TO BE APPROVED BY DESIGNER PRIOR CONSTRUCTION
MT		PERFORATED SHEET PINK POWDER COATED FINISH COUNTER FASCIA	BUILDER	ANY SUBSTITUTION MATERIAL TO BE APPROVED BY DESIGNER PRIOR CONSTRUCTION
		SAN JAMAR CUP DISPENSAR QUANTITY: 4 SIZE TBC WITH CLIENT	NISBETS	ANY SUBSTITUTION MATERIAL TO BE APPROVED BY DESIGNER PRIOR CONSTRUCTION

SCENTRE GROUP		APPROVED DESIGN CONCEPT	
DATE:	17/09/2020	VERSION: 2	
WESTFIELD:	Warringah Mall		
SHOP:	25K1		
RETAIL DESIGN MANAGER:	Lana Munro		
<p>Consent of the concept is granted to the lessee for the shopfront, shop layout and signage shown in these plans. Scentre Group notations including comments and handwritten changes must be complied with.</p> <p>ENGINEER'S CERTIFICATE REQUIRED TO VERIFY STRUCTURAL ADEQUACY. SHOPFITTERS MUST KEEP A COPY OF THESE SCENTRE GROUP STAMPED DRAWINGS ON SITE AT ALL TIMES. (DESTROY ALL PREVIOUS ISSUES AND ALL UNSTAMPED DRAWINGS)</p>			

 <div>suite 42, Level 7, 591 George St, Sydney P (+61 2) 8068 1755 F (+61 2) 9264 8787 joel@liteco.com.au</div>	CLIENT YOGURTBERRY	<div>NOTES</div> <ul style="list-style-type: none">All drawings to be read in conjunction with all engineers documentation and specification.Contractor to ensure all new building works, new fittings and fixtures are installed to the current BCA, Australian Standards and Work Cover Regulations.The Contractor shall use figured dimensions in preference to scaled dimensions. All dimensions shall be verified on site by the Contractors prior to commencing any work or preparing shop drawings.All materials are to be used in accordance with manufacturer's specifications and instructions, and to comply with relevant Australian Standards.Partition set-out to be approved by Project Manager on-site prior to construction.COPYRIGHT These drawings and the designs are the property of Liteco project and must not be used, retained or copied without written permission of Liteco project.					TITLE	DRAWING NO. 0008
	PROJECT WESTFIELD WARRINGAH MALL KIOSK 25K1						MATERIAL SCHEDULE	SCALE NA @ A3
			B	24.08.2020	JC	DESIGN APPROVAL		
			A	30.07.2020	JC	DESIGN APPROVAL	DRAWN BY JC	CHECKED JC
			ISSUE	DATE	INITIALS	REVISION DETAIL	CLIENT APPROVAL	ISSUE B


SCENTRE GROUP

APPROVED DESIGN CONCEPT

DATE:	17/09/2020	VERSION: 2
WESTFIELD:	Warringah Mall	
SHOP:	25K1	
RETAIL DESIGN MANAGER:	Lana Munro	

Consent of the concept is granted to the lessee for the shopfront, shop layout and signage shown in these plans. Scentre Group notations including comments and handwritten changes must be complied with.

ENGINEER'S CERTIFICATE REQUIRED TO VERIFY STRUCTURAL ADEQUACY. SHOPFITTERS MUST KEEP A COPY OF THESE SCENTRE GROUP STAMPED DRAWINGS ON SITE AT ALL TIMES. (DESTROY ALL PREVIOUS ISSUES AND ALL UNSTAMPED DRAWINGS)

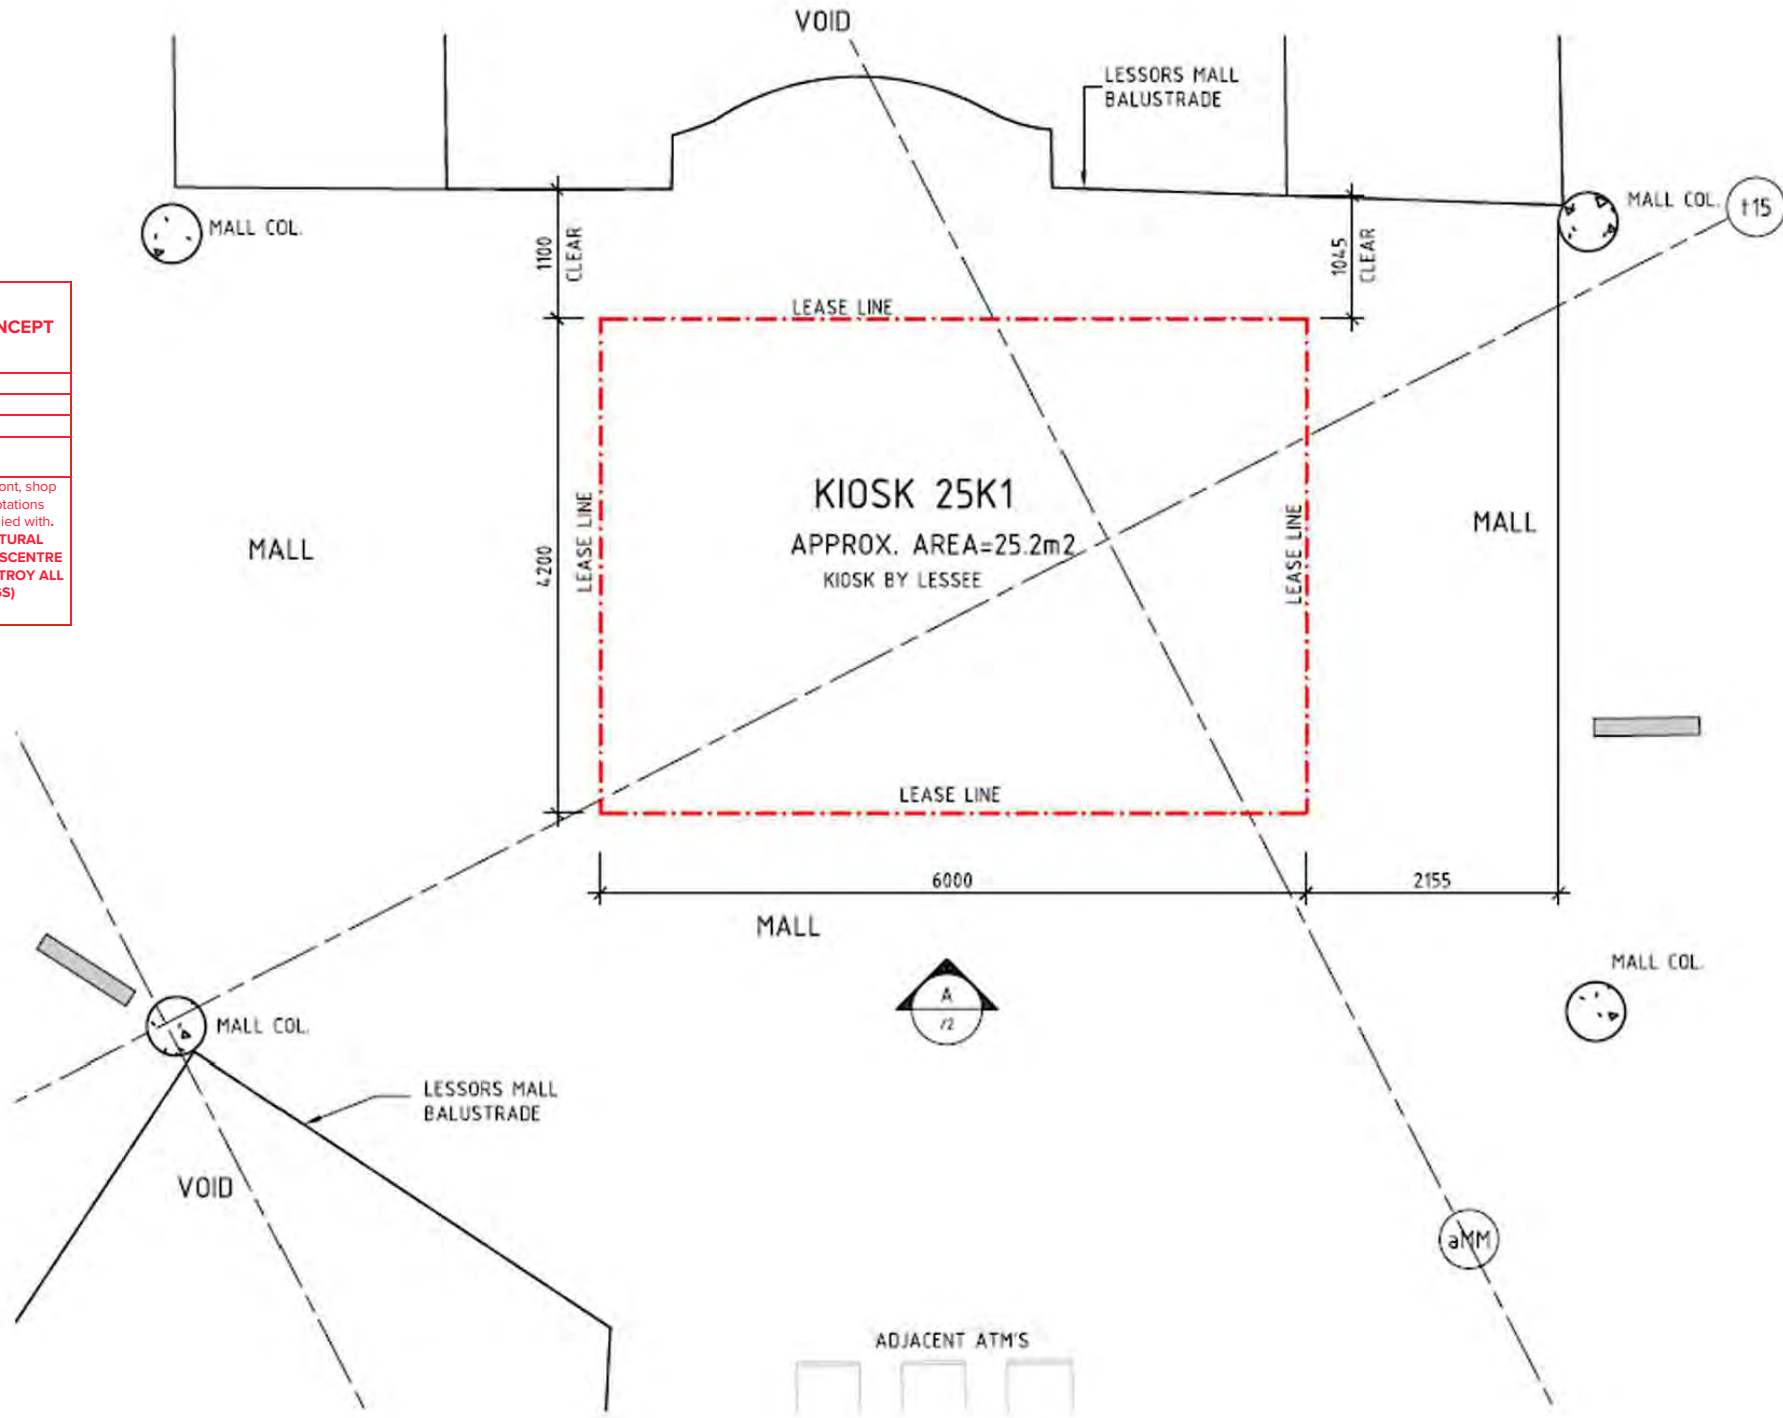

THE LESSEE'S DESIGNER IN CONJUNCTION WITH THE CENTRES FACILITIES MANAGER IS TO VERIFY ALL DIMENSIONS, COLUMN LOCATIONS, ADJ STRUCTURES, FINISHES & SERVICE LOCATIONS, PRIOR TO COMMENCING DESIGN DOCUMENTATION.

NOTE:
LESSEE SHALL SETBACK ALL FITOUT FIXTURES 1000mm MIN. FROM EDGE OF BALUSTRADE/HANDRAIL TO VOID.

NOTE:
LOCATION OF EXISTING STANDARD SERVICES TO BE CONFIRMED ON SITE.

NOTE:
LESSEES FITOUT NOT TO BE ATTACHED TO AND/OR SUPPORTED FROM MALL COLUMN.


NOTE:
CANOPY OVER KIOSK MAY BE REQUIRED SUBJECT TO COUNCIL REQUIREMENTS.
CANOPY DESIGN/CONSTRUCTION MUST NOT BE FIXED TO OR SUPPORTED FROM MALL COLUMN, BULKHEAD, CEILING, ESCALATOR AND TRAVELATOR.
CANOPY STRUCTURE TO BE AN INTEGRAL PART OF KIOSK.



NOTES:
ALL DIMENSIONS TO BE CHECKED ON SITE WRITTEN DIMENSIONS ONLY TO BE USED. ALL DIMENSIONS ARE IN MILLIMETRES.
ALL SERVICES ARE INDICATIVE ONLY AND SHOULD BE CHECKED ON SITE.
LESSEES SHOPFRONT IS NOT TO BE ATTACHED TO, OR SUPPORTED FROM LESSORS BULKHEAD ALL LESSEES WORKS TO BE SUPPORTED ONLY FROM MAIN STRUCTURE OVER AND ALLOW FOR MOVEMENT IN THE STRUCTURE
LESSEE TO CROSS THE END OF THE RIGHT HAND INTERTENANCY WALL (LOOKING AT THE SHOP FROM THE MALL) UNLESS NOTED OTHERWISE ON THE LEASE PLAN OR AGREED BY THE LESSOR
CEILING HEIGHT MAY BE ABOVE INTERTENANCY PARTITION, AT LESSEE'S COST WITH LESSORS APPROVAL
THE TENANT SHOULD, BEFORE PROCEEDING WITH FITOUT DESIGN, SITE SURVEY THE PREMISES AND NOTE ANY FIXTURES OR CHANGE IN FLOOR LEVELS THAT MAY EFFECT THEIR DESIGN

- LEGEND:**
- OUT OF SCOPE
 - EXISTING WALL
 - RELOCATED WORK

NOTE:
EXTG. STEEL STRUCTURE TO BE REMOVED. ANY EXISTING SERVICES TO BE RELOCATED TO THIS LOCATION REQUIRED.

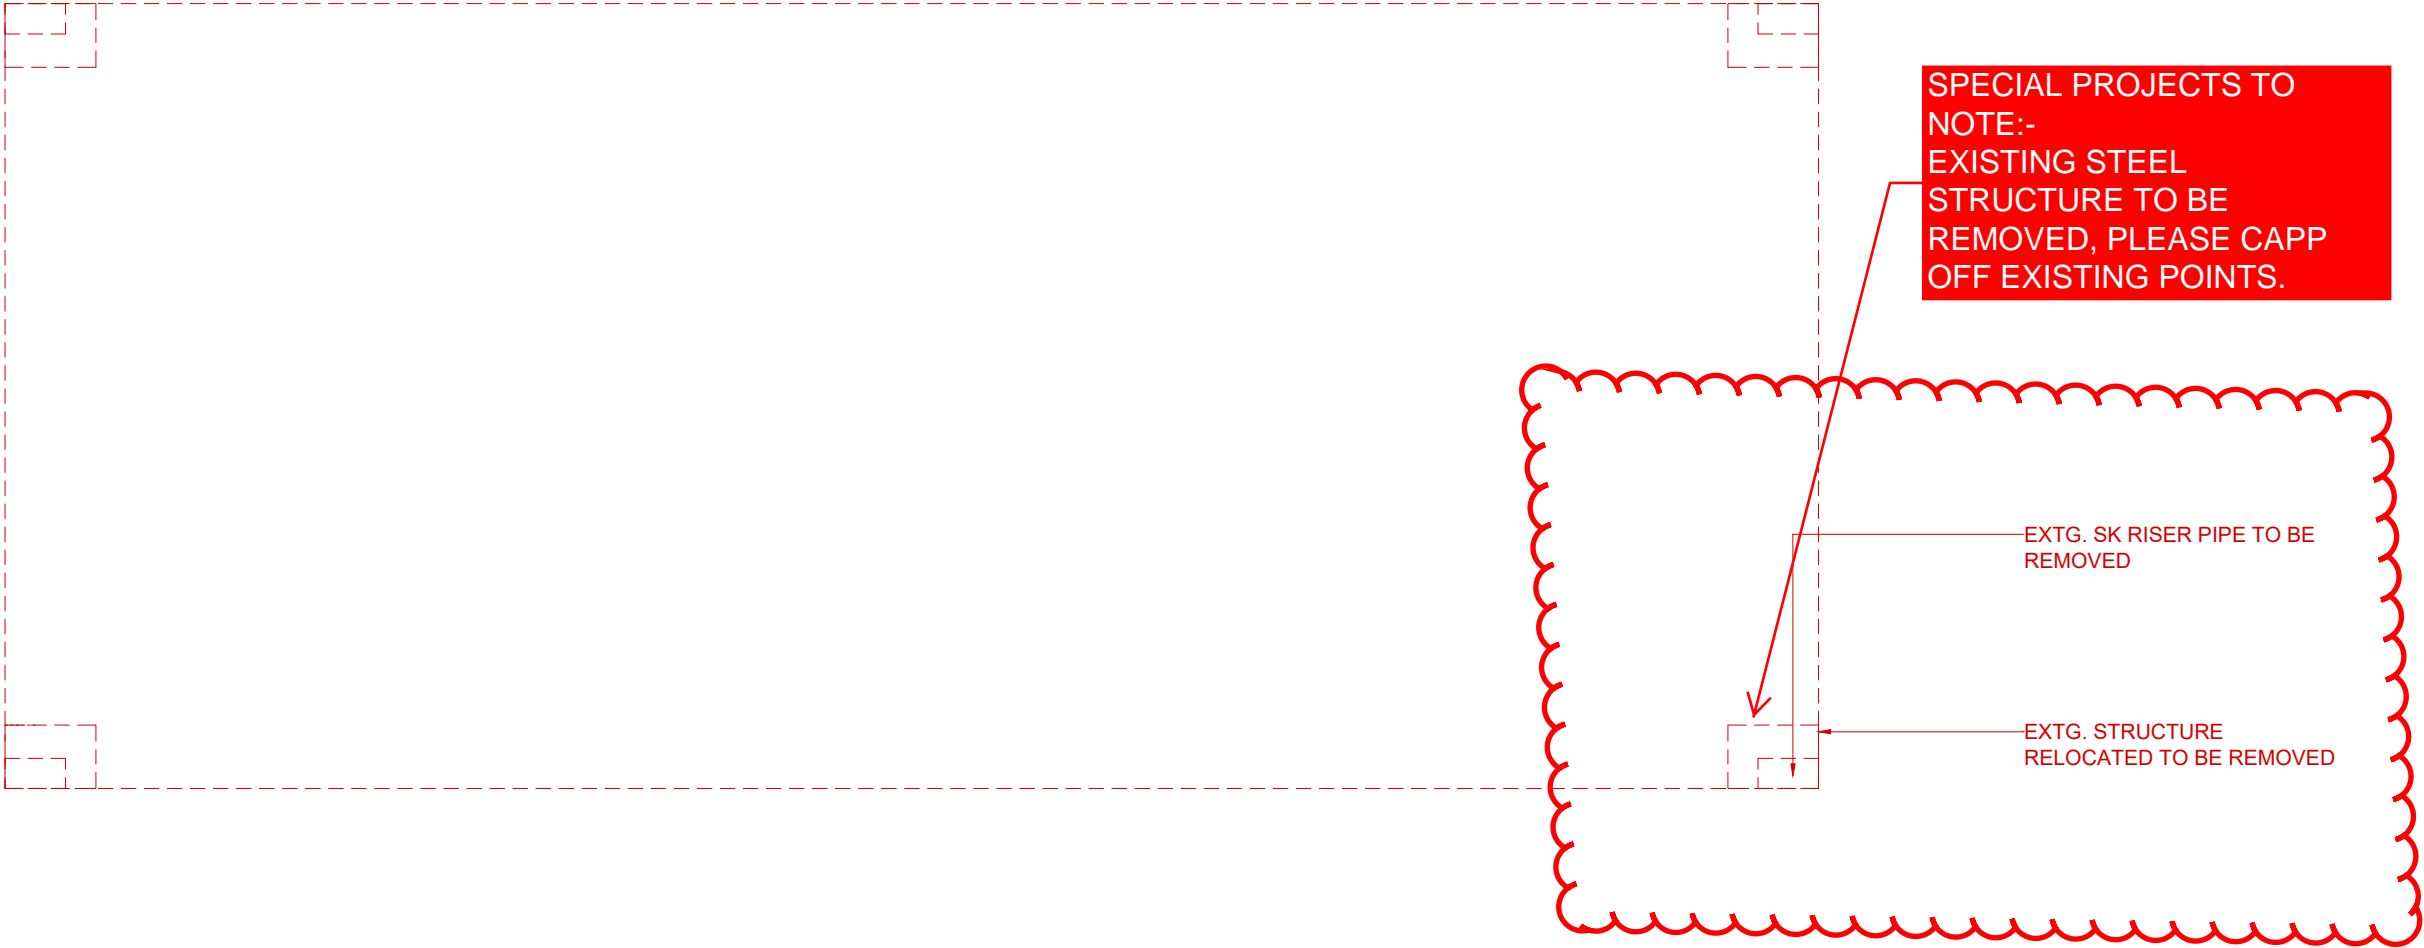SCENTRE GROUP		APPROVED DESIGN CONCEPT	
DATE:	17/09/2020	VERSION: 2	
WESTFIELD:	Warringah Mall		
SHOP:	25K1		
RETAIL DESIGN MANAGER:	Lana Munro		
Consent of the concept is granted to the lessee for the shopfront, shop layout and signage shown in these plans. Scentre Group notations including comments and handwritten changes must be complied with.			
ENGINEER'S CERTIFICATE REQUIRED TO VERIFY STRUCTURAL ADEQUACY. SHOPFITTERS MUST KEEP A COPY OF THESE SCENTRE GROUP STAMPED DRAWINGS ON SITE AT ALL TIMES. (DESTROY ALL PREVIOUS ISSUES AND ALL UNSTAMPED DRAWINGS)			



<div></div> <div>suite 42, Level 7, 591 George St, Sydney P (+61 2) 8068 1755 F (+61 2) 9264 8787 joel@liteco.com.au</div>	CLIENT YOGURTBERRY	NOTES <ul style="list-style-type: none">• All drawings to be read in conjunction with all engineers documentation and specification.• Contractor to ensure all new building works, new fittings and fixtures are installed to the current BCA, Australian Standards and Work Cover Regulations.• The Contractor shall use figured dimensions in preference to scaled dimensions. All dimensions shall be verified on site by the Contractors prior to commencing any work or preparing shop drawings.• All materials are to be used in accordance with manufacturer's specifications and instructions, and to comply with relevant Australian Standards.• Partition set-out to be approved by Project Manager on-site prior to construction.• COPYRIGHT These drawings and the designs are the property of Liteco project and must not be used, retained or copied without written permission of Liteco project.					TITLE	<div>DEMOLITION PLAN</div>	DRAWING NO. 0101
	PROJECT WESTFIELD WARRINGAH MALL KIOSK 25K1		C	11.09.2020	JC	DESIGN APPROVAL			
			B	24.08.2020	JC	DESIGN APPROVAL			CHECKED JC
			A	30.07.2020	JC	DESIGN APPROVAL	DRAWN BY JC		ISSUE C
			ISSUE	DATE	INITIALS	REVISION DETAIL	CLIENT APPROVAL		

LEGEND:

OUT OF SCOPE

EXISTING WALL


NEW WALL

SCENTRE GROUP

APPROVED DESIGN CONCEPT

DATE:	17/09/2020	VERSION: 2
WESTFIELD:	Warringah Mall	
SHOP:	25K1	
RETAIL DESIGN MANAGER:	Lana Munro	

Consent of the concept is granted to the lessee for the shopfront, shop layout and signage shown in these plans. Scentre Group notations including comments and handwritten changes must be complied with.
ENGINEER'S CERTIFICATE REQUIRED TO VERIFY STRUCTURAL ADEQUACY. SHOPFITTERS MUST KEEP A COPY OF THESE SCENTRE GROUP STAMPED DRAWINGS ON SITE AT ALL TIMES. (DESTROY ALL PREVIOUS ISSUES AND ALL UNSTAMPED DRAWINGS)

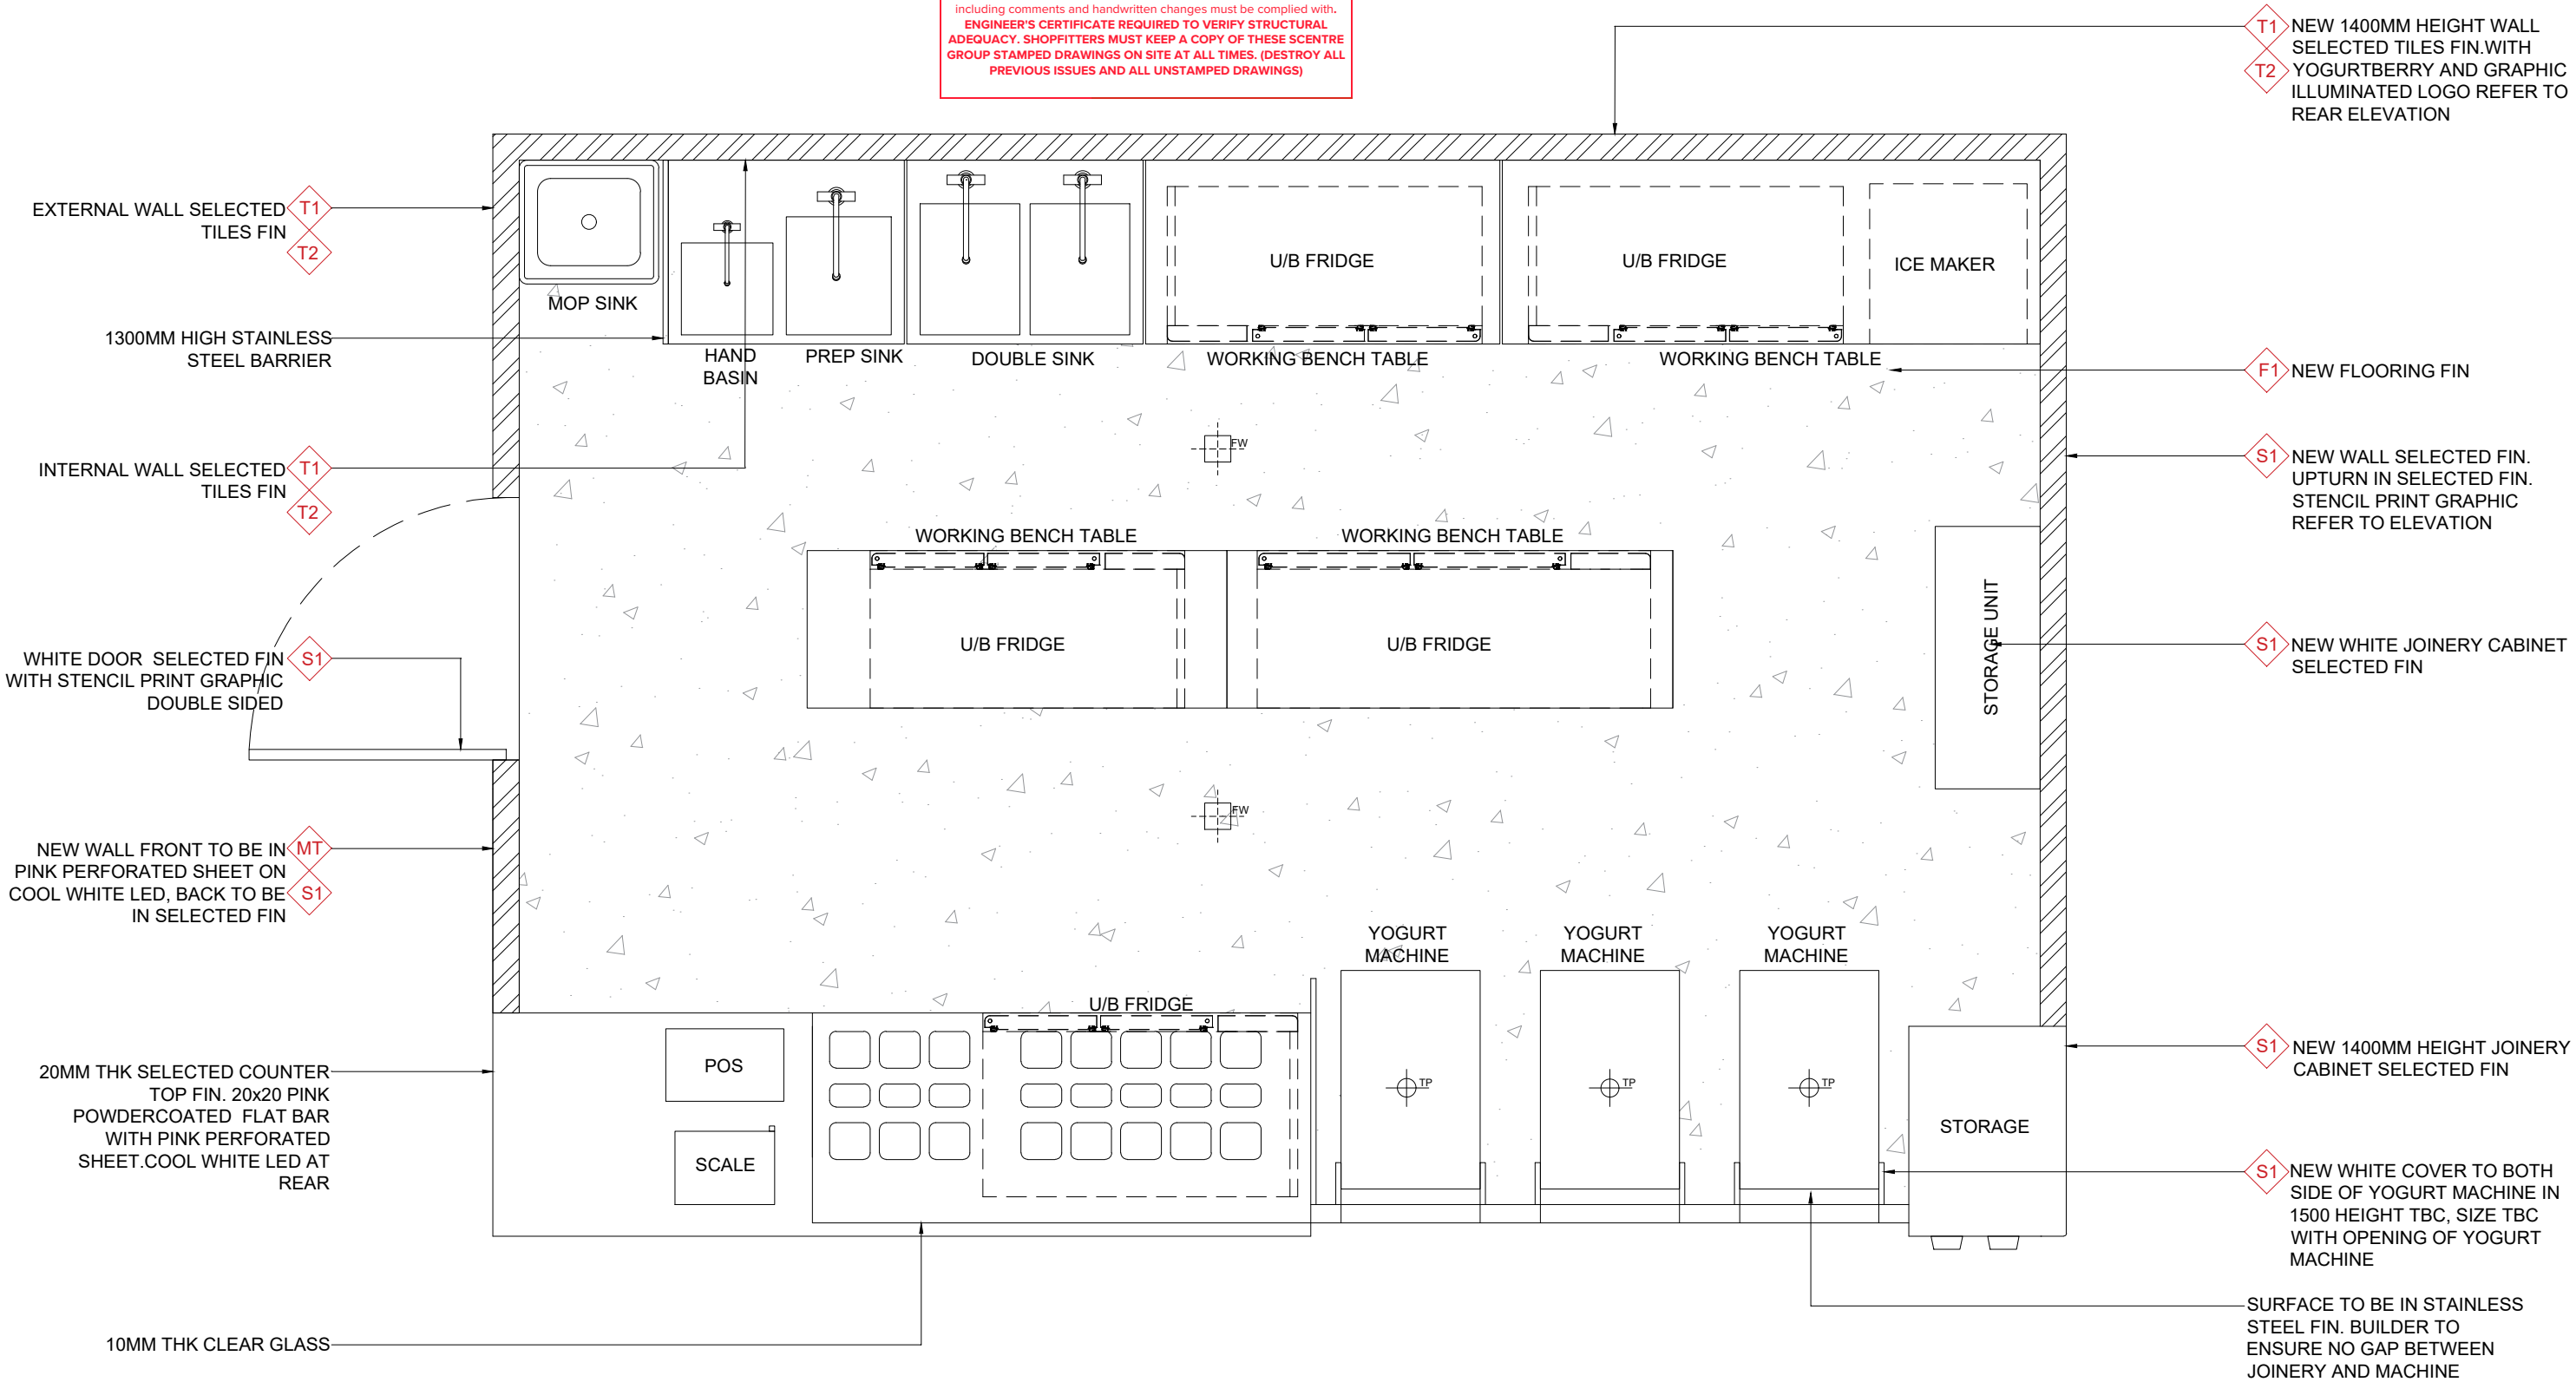

LITECO

STUDIO

suite 42, Level 7, 591 George St, Sydney

P (+61 2) 8068 1755

F (+61 2) 9264 8787

joel@liteco.com.au

CLIENT

YOGURTBERRY

PROJECT

WESTFIELD WARRINGAH MALL KIOSK 25K1

NOTES

- All drawings to be read in conjunction with all engineers documentation and specification.
- Contractor to ensure all new building works, new fittings and fixtures are installed to the current BCA, Australian Standards and Work Cover Regulations.
- The Contractor shall use figured dimensions in preference to scaled dimensions. All dimensions shall be verified on site by the Contractors prior to commencing any work or preparing shop drawings.
- All materials are to be used in accordance with manufacturer's specifications and instructions, and to comply with relevant Australian Standards.
- Partition set-out to be approved by Project Manager on-site prior to construction.
- COPYRIGHT These drawings and the designs are the property of Liteco project and must not be used, retained or copied without written permission of Liteco project.

D	11.09.2020	JC	DESIGN APPROVAL	TITLE	DRAWING NO.
C	02.09.2020	JC	DESIGN APPROVAL		
B	24.08.2020	JC	DESIGN APPROVAL		
A	30.07.2020	JC	DESIGN APPROVAL	DRAWN BY	JC
ISSUE	DATE	INITIALS	REVISION DETAIL	CLIENT APPROVAL	ISSUE

LAYOUT PLAN

SCALE

1:25 @ A3

CHECKED

JC

ISSUE

D

■ EXISTING WALL

 NEW WALL


NOTE:



ALL DIMENSION TO BE CONFIRMED ON SITE PRIOR CONSTRUCTION

SCENTRE GROUP		APPROVED DESIGN CONCEPT	
DATE:	17/09/2020	VERSION: 2	
WESTFIELD:	Warringah Mall		
SHOP:	25K1		
RETAIL DESIGN MANAGER:	Lana Munro		

Consent of the concept is granted to the lessee for the shopfront, shop layout and signage shown in these plans. Scentre Group notations including comments and handwritten changes must be complied with

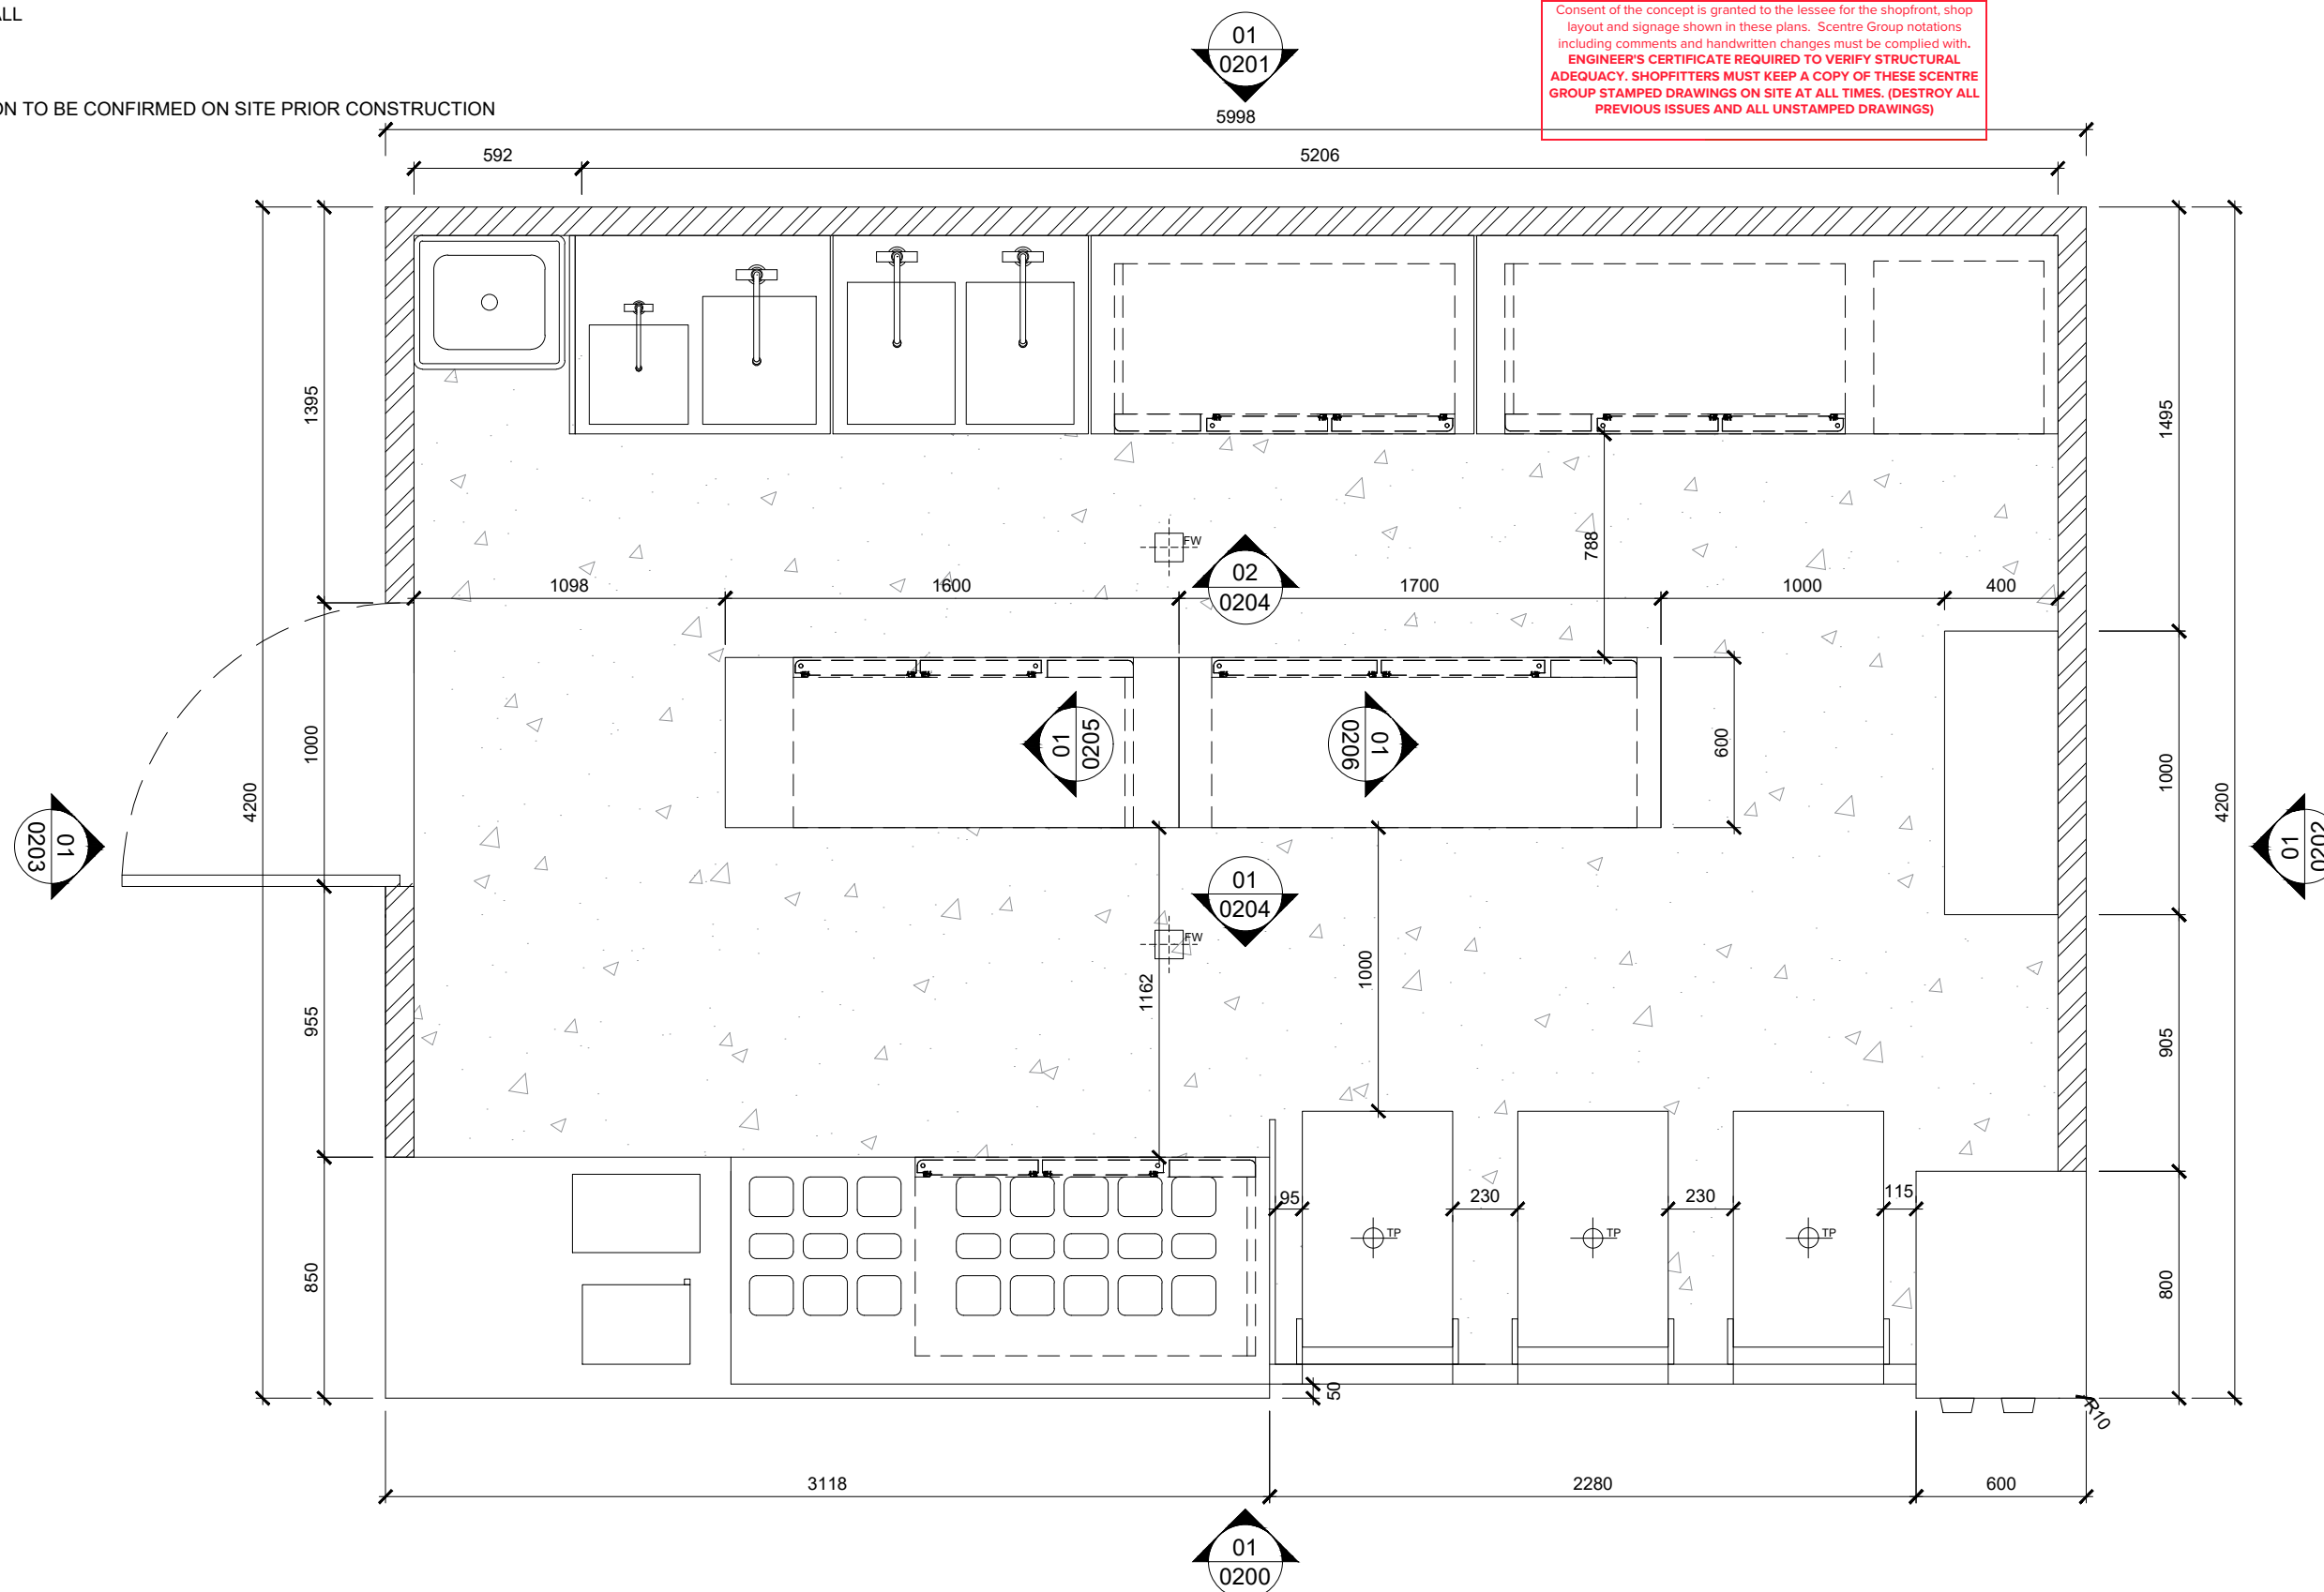ENGINEER'S CERTIFICATE REQUIRED TO VERIFY STRUCTURAL ADEQUACY. SHOPFITTERS MUST KEEP A COPY OF THESE SCENTRE GROUP STAMPED DRAWINGS ON SITE AT ALL TIMES. (DESTROY ALL PREVIOUS ISSUES AND ALL UNSTAMPED DRAWINGS)



<div><p>suite 42, Level 7, 591 George St, Sydney P (+61 2) 8068 1755 F (+61 2) 9264 8787 joel@liteco.com.au</p></div>	CLIENT YOGURT BERRY	<div>NOTES</div> <ul style="list-style-type: none">• All drawings to be read in conjunction with all engineers documentation and specification.• Contractor to ensure all new building works, new fittings and fixtures are installed to the current BCA, Australian Standards and Work Cover Regulations.• The Contractor shall use figured dimensions in preference to scaled dimensions. All dimensions shall be verified on site by the Contractors prior to commencing any work or preparing shop drawings.• All materials are to be used in accordance with manufacturer's specifications and instructions, and to comply with relevant Australian Standards.• Partition set-out to be approved by Project Manager on-site prior to construction.• COPYRIGHT These drawings and the designs are the property of Liteco project and must not be used, retained or copied without written permission of Liteco project.	D	11.09.2020	JC	DESIGN APPROVAL	<div>TITLE</div> <div>DIMENSION PLAN </div>	DRAWING NO.	0103
	PROJECT WESTFIELD WARRINGAH MALL KIOSK 25K1		C	02.09.2020	JC	DESIGN APPROVAL		SCALE	1:25 @ A3
			B	24.08.2020	JC	DESIGN APPROVAL		DRAWN BY JC	CHECKED JC
			A	30.07.2020	JC	DESIGN APPROVAL	ISSUE D		
	ISSUE		DATE	INITIALS	REVISION DETAIL	CLIENT APPROVAL			

LEGEND:

OUT OF SCOPE

EXISTING WALL

NEW WALL


NOTE:
POSITION OF **T1** & **T2** TILES REFER TO ELEVATION

SCENTRE GROUP

APPROVED DESIGN CONCEPT

DATE:	17/09/2020	VERSION: 2
WESTFIELD:	Warringah Mall	
SHOP:	25K1	
RETAIL DESIGN MANAGER:	Lana Munro	

Consent of the concept is granted to the lessee for the shopfront, shop layout and signage shown in these plans. Scentre Group notations including comments and handwritten changes must be complied with. **ENGINEER'S CERTIFICATE REQUIRED TO VERIFY STRUCTURAL ADEQUACY. SHOPFITTERS MUST KEEP A COPY OF THESE SCENTRE GROUP STAMPED DRAWINGS ON SITE AT ALL TIMES. (DESTROY ALL PREVIOUS ISSUES AND ALL UNSTAMPED DRAWINGS)**

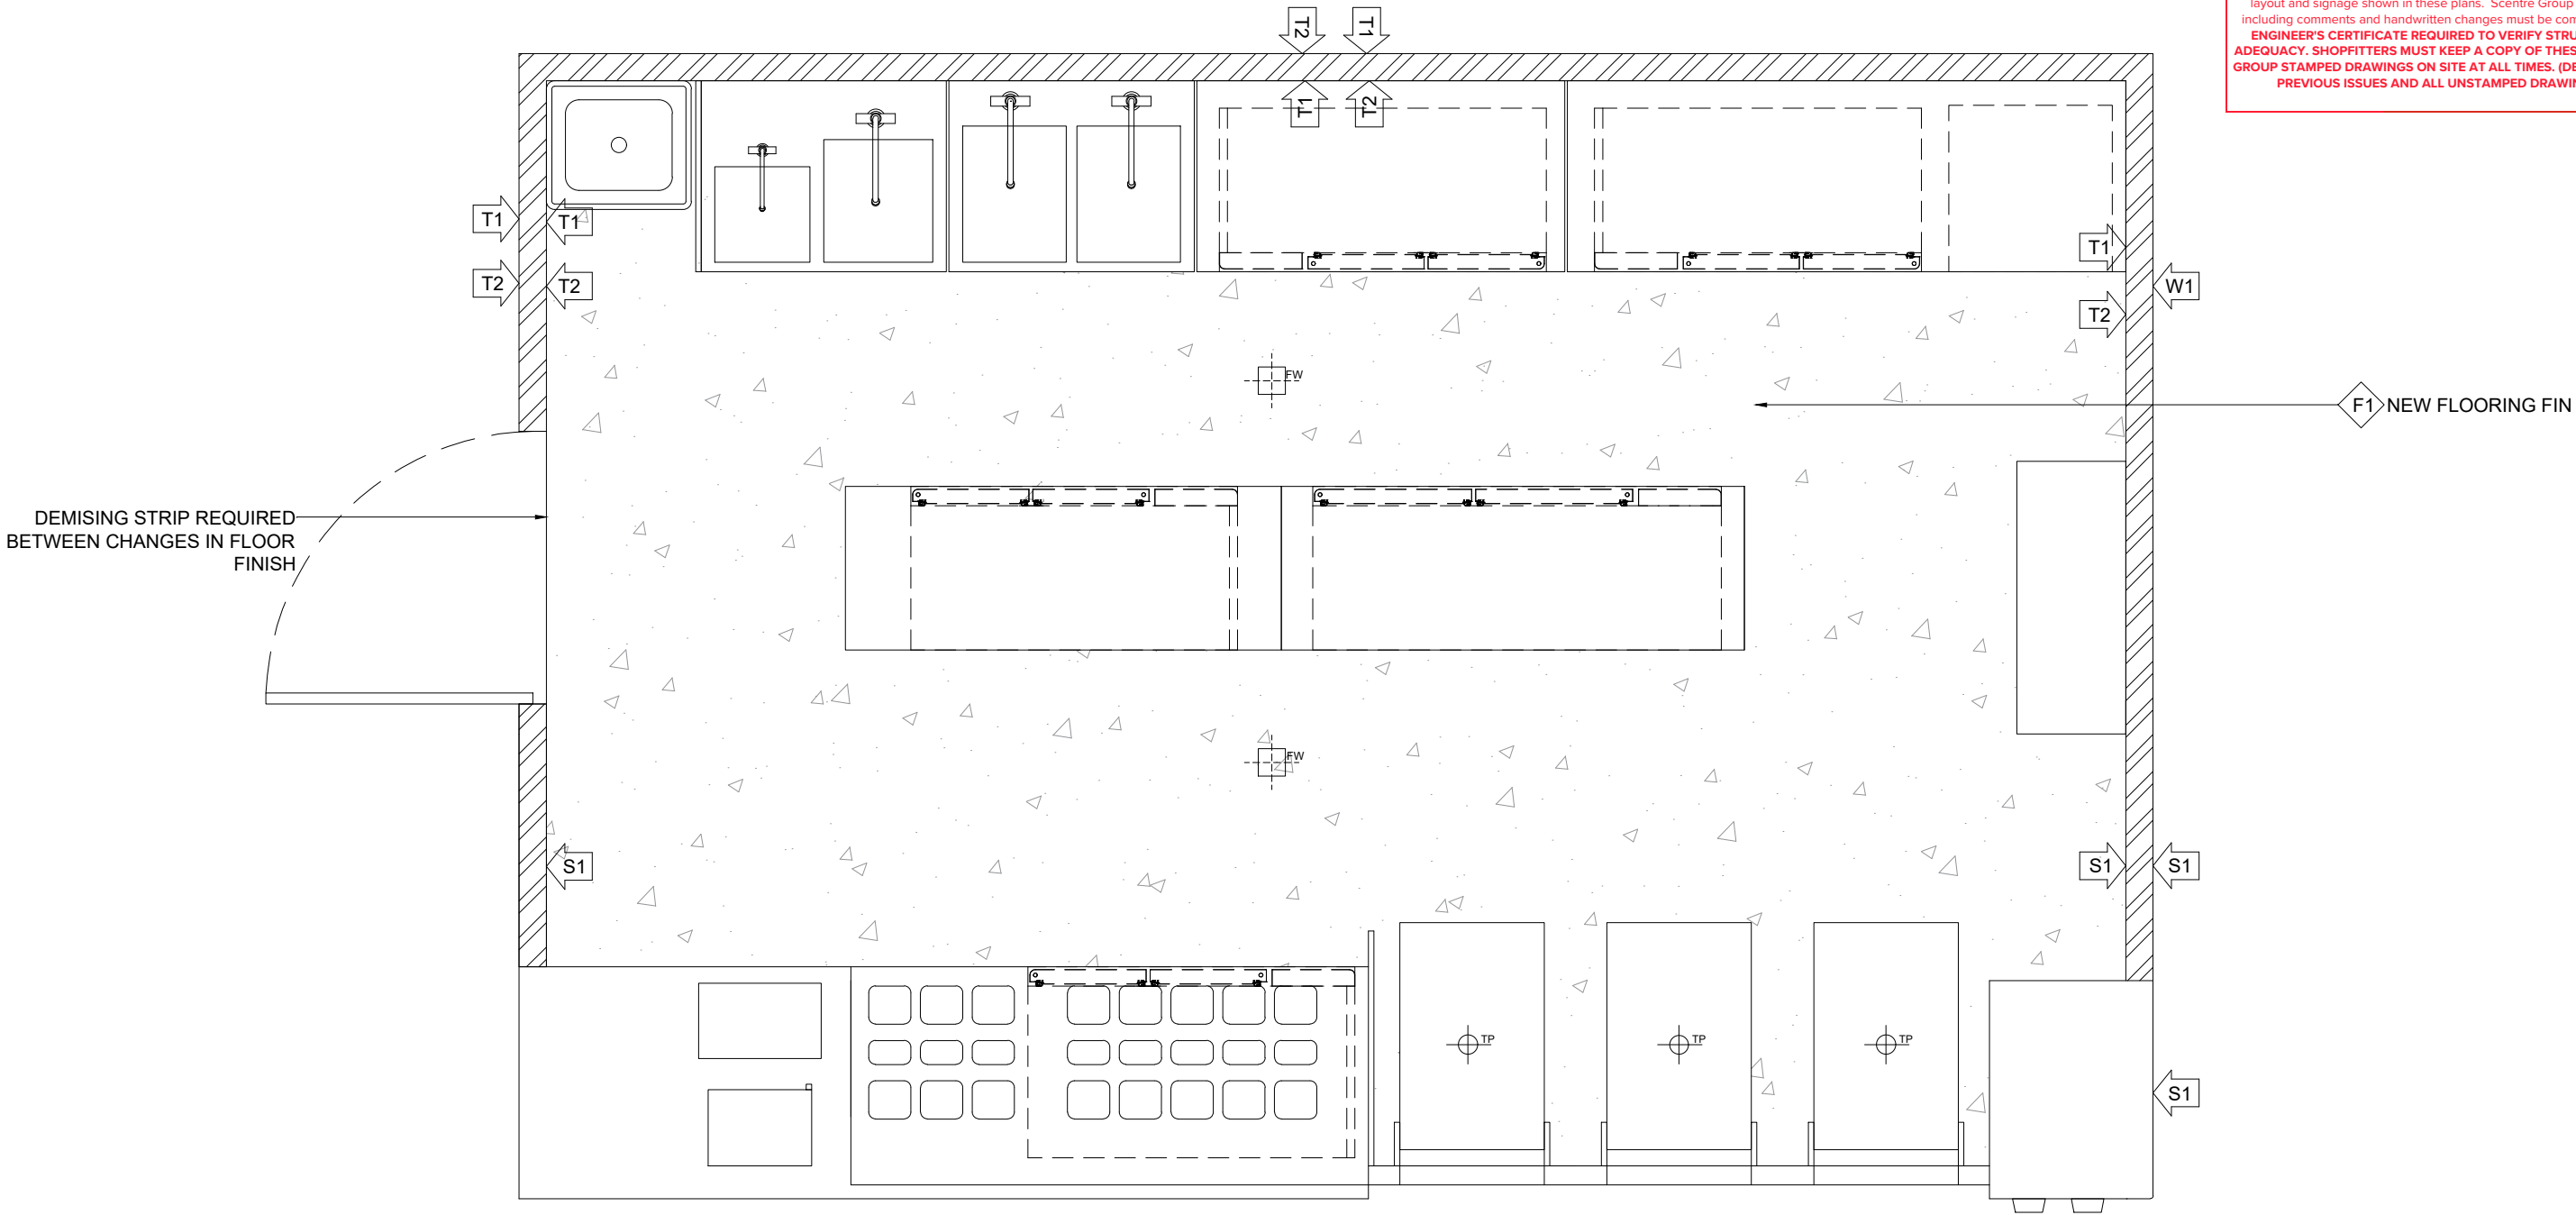

LITECO


STUDIO

suite 42, Level 7, 591 George St, Sydney
P (+61 2) 8068 1755
F (+61 2) 9264 8787
joel@liteco.com.au

CLIENT
YOGURTBERRY

PROJECT
WESTFIELD WARRINGAH MALL KIOSK 25K1

- NOTES
- All drawings to be read in conjunction with all engineers documentation and specification.
 - Contractor to ensure all new building works, new fittings and fixtures are installed to the current BCA, Australian Standards and Work Cover Regulations.
 - The Contractor shall use figured dimensions in preference to scaled dimensions. All dimensions shall be verified on site by the Contractors prior to commencing any work or preparing shop drawings.
 - All materials are to be used in accordance with manufacturer's specifications and instructions, and to comply with relevant Australian Standards.
 - Partition set-out to be approved by Project Manager on-site prior to construction.
 - COPYRIGHT These drawings and the designs are the property of Liteco project and must not be used, retained or copied without written permission of Liteco project.

D	11.09.2020	JC	DESIGN APPROVAL	TITLE FINISHES PLAN 	DRAWING NO. 0104
C	02.09.2020	JC	DESIGN APPROVAL		SCALE 1:25 @ A3
B	24.08.2020	JC	DESIGN APPROVAL		CHECKED JC
A	30.07.2020	JC	DESIGN APPROVAL	DRAWN BY JC	ISSUE D
ISSUE	DATE	INITIALS	REVISION DETAIL	CLIENT APPROVAL	

LEGEND:

- OUT OF SCOPE
- EXISTING WALL
- NEW WALL

NOTE:

ALL ELECTRICAL TO BE INSTALLED TO THE BCA & AUSTRALIAN STANDARDS

BUILDER TO FOLLOW MANUFACTURE INSTRUCTIONS FOR ALL EQUIPMENT INSTALLED

BUILDER TO ALLOW FOR CABLE PORTS IN COUNTER TO ACCESS GPO AS REQUIRED. COLOUR OF CABLE PORTS TO MATCH JOINERY

ENSURE DEDICATED POWER IS PROVIDED TO ALL SIGNAGE & EQUIPMENT

BUILDER AND CONTRACTOR TO CHECK ALL HYDRAULIC POINTS, LOCATION AND DIMENSION FOR SUITABILITY PRIOR CONSTRUCTION

ALL WORKS TO BE A HIGH STANDARD AND MUST COMPLY WITH THE BCA, AUSTRALIAN STANDARDS AND ALL OTHER RELEVANT REGULATIONS

ALL CORE HOLE SIZE REQUIRED 100MM


ALL 3 TUNDISH POINT REQUIRED TRAP UNDER THE SLAB



LEGEND	DESCRIPTION OF ITEM
	DRAINAGE POINT
	COLD AND HOT WATER CONNECTION
	COLD WATER CONNECTION
	TUNDISH POINT
	FLOOR WASTE
	TELEPHONE OUTLET
	DOUBLE GPO ABOVE FLOOR APPROX 300MM
	DOUBLE GPO ABOVE BENCH APPROX 1000MM
	DOUBLE GPO TO SUIT EQUIPMENT, CONTRACTOR TO ENSURE SUITABLE AMPs
	PHASE INDUSTRIAL POWER SOCKETS FOR YOGURT MACHINE
	DATA POINT
	DOUBLE GPO UNDER BENCH FOR JOINERY
	ELECTRIC DISTRIBUTION BOARD

Waterproofing required

SCENTRE GROUP		APPROVED DESIGN CONCEPT	
DATE:	17/09/2020	VERSION: 2	
WESTFIELD:	Warringah Mall		
SHOP:	25K1		
RETAIL DESIGN MANAGER:	Lana Munro		
Consent of the concept is granted to the lessee for the shopfront, shop layout and signage shown in these plans. Scentre Group notations including comments and handwritten changes must be complied with. ENGINEER'S CERTIFICATE REQUIRED TO VERIFY STRUCTURAL ADEQUACY. SHOPFITTERS MUST KEEP A COPY OF THESE SCENTRE GROUP STAMPED DRAWINGS ON SITE AT ALL TIMES. (DESTROY ALL PREVIOUS ISSUES AND ALL UNSTAMPED DRAWINGS)			

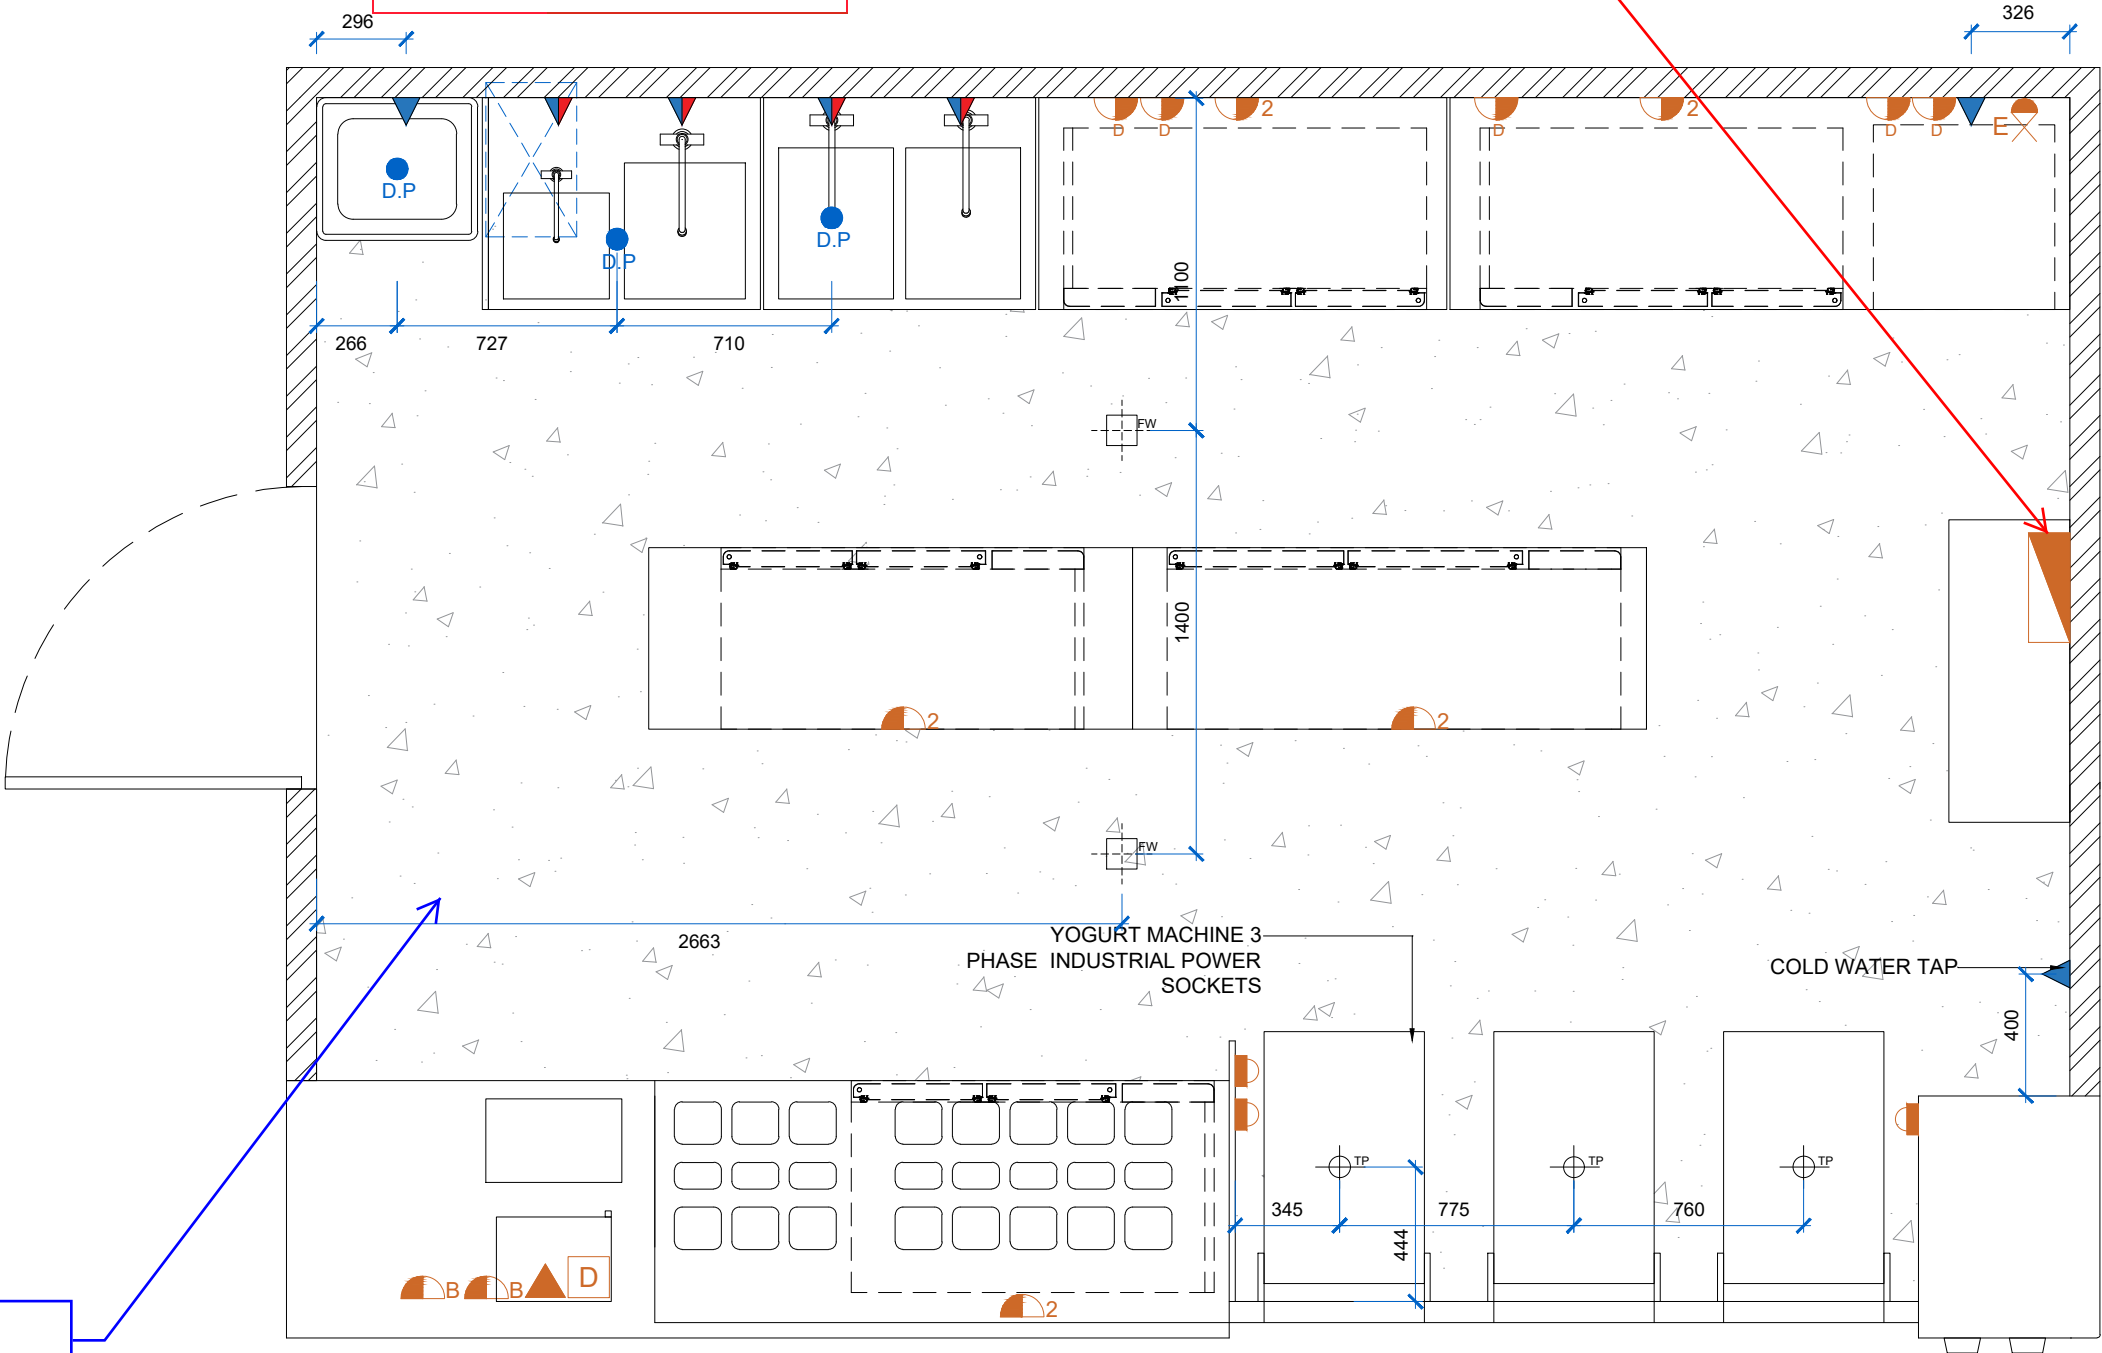SPECIAL PROJECTS TO NOTE:-
EDB LOCATION AS SHOWN



<div></div> <div>suite 42, Level 7, 591 George St, Sydney P (+61 2) 8068 1755 F (+61 2) 9264 8787 joel@liteco.com.au</div>	CLIENT YOGURTBERRY	<p>NOTES</p> <ul style="list-style-type: none">• All drawings to be read in conjunction with all engineers documentation and specification.• Contractor to ensure all new building works, new fittings and fixtures are installed to the current BCA, Australian Standards and Work Cover Regulations.• The Contractor shall use figured dimensions in preference to scaled dimensions. All dimensions shall be verified on site by the Contractors prior to commencing any work or preparing shop drawings.• All materials are to be used in accordance with manufacturer's specifications and instructions, and to comply with relevant Australian Standards.• Partition set-out to be approved by Project Manager on-site prior to construction.• COPYRIGHT These drawings and the designs are the property of Liteco project and must not be used, retained or copied without written permission of Liteco project.	D	11.09.2020	JC	DESIGN APPROVAL	TITLE ELECTRICAL & HYDRAULIC PLAN 	DRAWING NO. 0105	
	PROJECT WESTFIELD WARRINGAH MALL KIOSK 25K1		C	02.09.2020	JC	DESIGN APPROVAL		SCALE 1:25 @ A3	
			B	24.08.2020	JC	DESIGN APPROVAL		CHECKED JC	
			A	30.07.2020	JC	DESIGN APPROVAL	DRAWN BY JC		
			ISSUE	DATE	INITIALS	REVISION DETAIL	CLIENT APPROVAL	ISSUE D	

LEGEND:

OUT OF SCOPE

EXISTING WALL

NEW WALL

NOTE:
NO LIGHTS ADDED TO ANY CEILING PLAN


SCENTRE GROUP

APPROVED DESIGN CONCEPT

DATE:	17/09/2020	VERSION: 2
WESTFIELD:	Warringah Mall	
SHOP:	25K1	
RETAIL DESIGN MANAGER:	Lana Munro	

Consent of the concept is granted to the lessee for the shopfront, shop layout and signage shown in these plans. Scentre Group notations including comments and handwritten changes must be complied with.

ENGINEER'S CERTIFICATE REQUIRED TO VERIFY STRUCTURAL ADEQUACY. SHOPFITTERS MUST KEEP A COPY OF THESE SCENTRE GROUP STAMPED DRAWINGS ON SITE AT ALL TIMES. (DESTROY ALL PREVIOUS ISSUES AND ALL UNSTAMPED DRAWINGS)

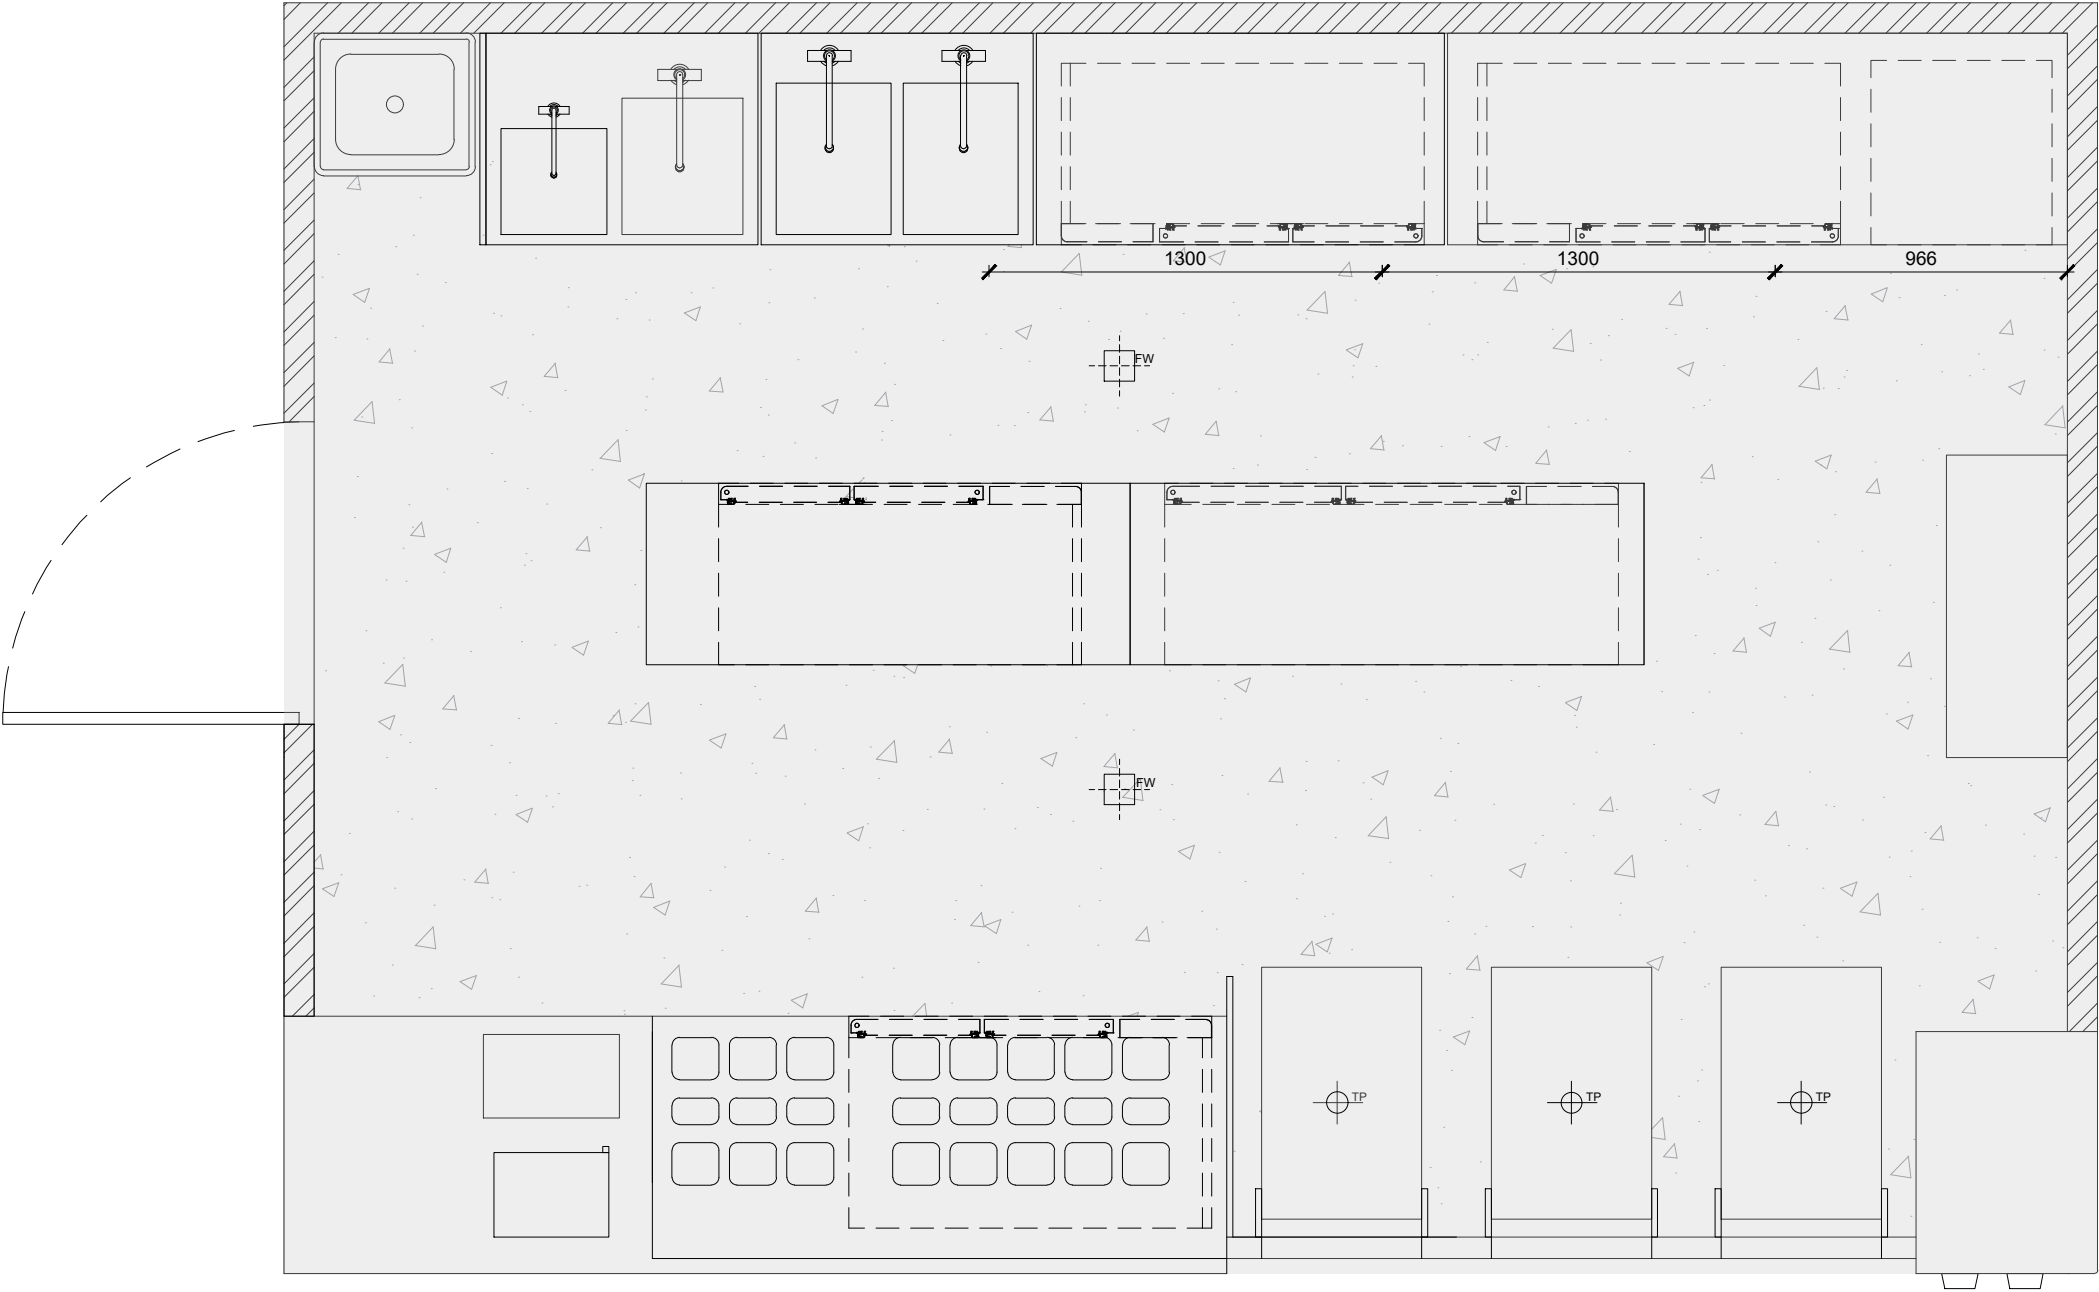

LITECO

STUDIO

suite 42, Level 7, 591 George St, Sydney
P (+61 2) 8068 1755
F (+61 2) 9264 8787
joel@liteco.com.au

CLIENT
YOGURTBERRY

PROJECT
WESTFIELD WARRINGAH MALL KIOSK 25K1

- NOTES
- All drawings to be read in conjunction with all engineers documentation and specification.
 - Contractor to ensure all new building works, new fittings and fixtures are installed to the current BCA, Australian Standards and Work Cover Regulations.
 - The Contractor shall use figured dimensions in preference to scaled dimensions. All dimensions shall be verified on site by the Contractors prior to commencing any work or preparing shop drawings.
 - All materials are to be used in accordance with manufacturer's specifications and instructions, and to comply with relevant Australian Standards.
 - Partition set-out to be approved by Project Manager on-site prior to construction.
 - COPYRIGHT These drawings and the designs are the property of Liteco project and must not be used, retained or copied without written permission of Liteco project.

				TITLE
C	11.09.2020	JC	DESIGN APPROVAL	CEILING PLAN
B	24.08.2020	JC	DESIGN APPROVAL	
A	30.07.2020	JC	DESIGN APPROVAL	
ISSUE	DATE	INITIALS	REVISION DETAIL	CLIENT APPROVAL


CEILING PLAN

DRAWN BY


JC

CLIENT APPROVAL

DRAWING NO.	0106
SCALE	1:25 @ A3
CHECKED	JC
ISSUE	C

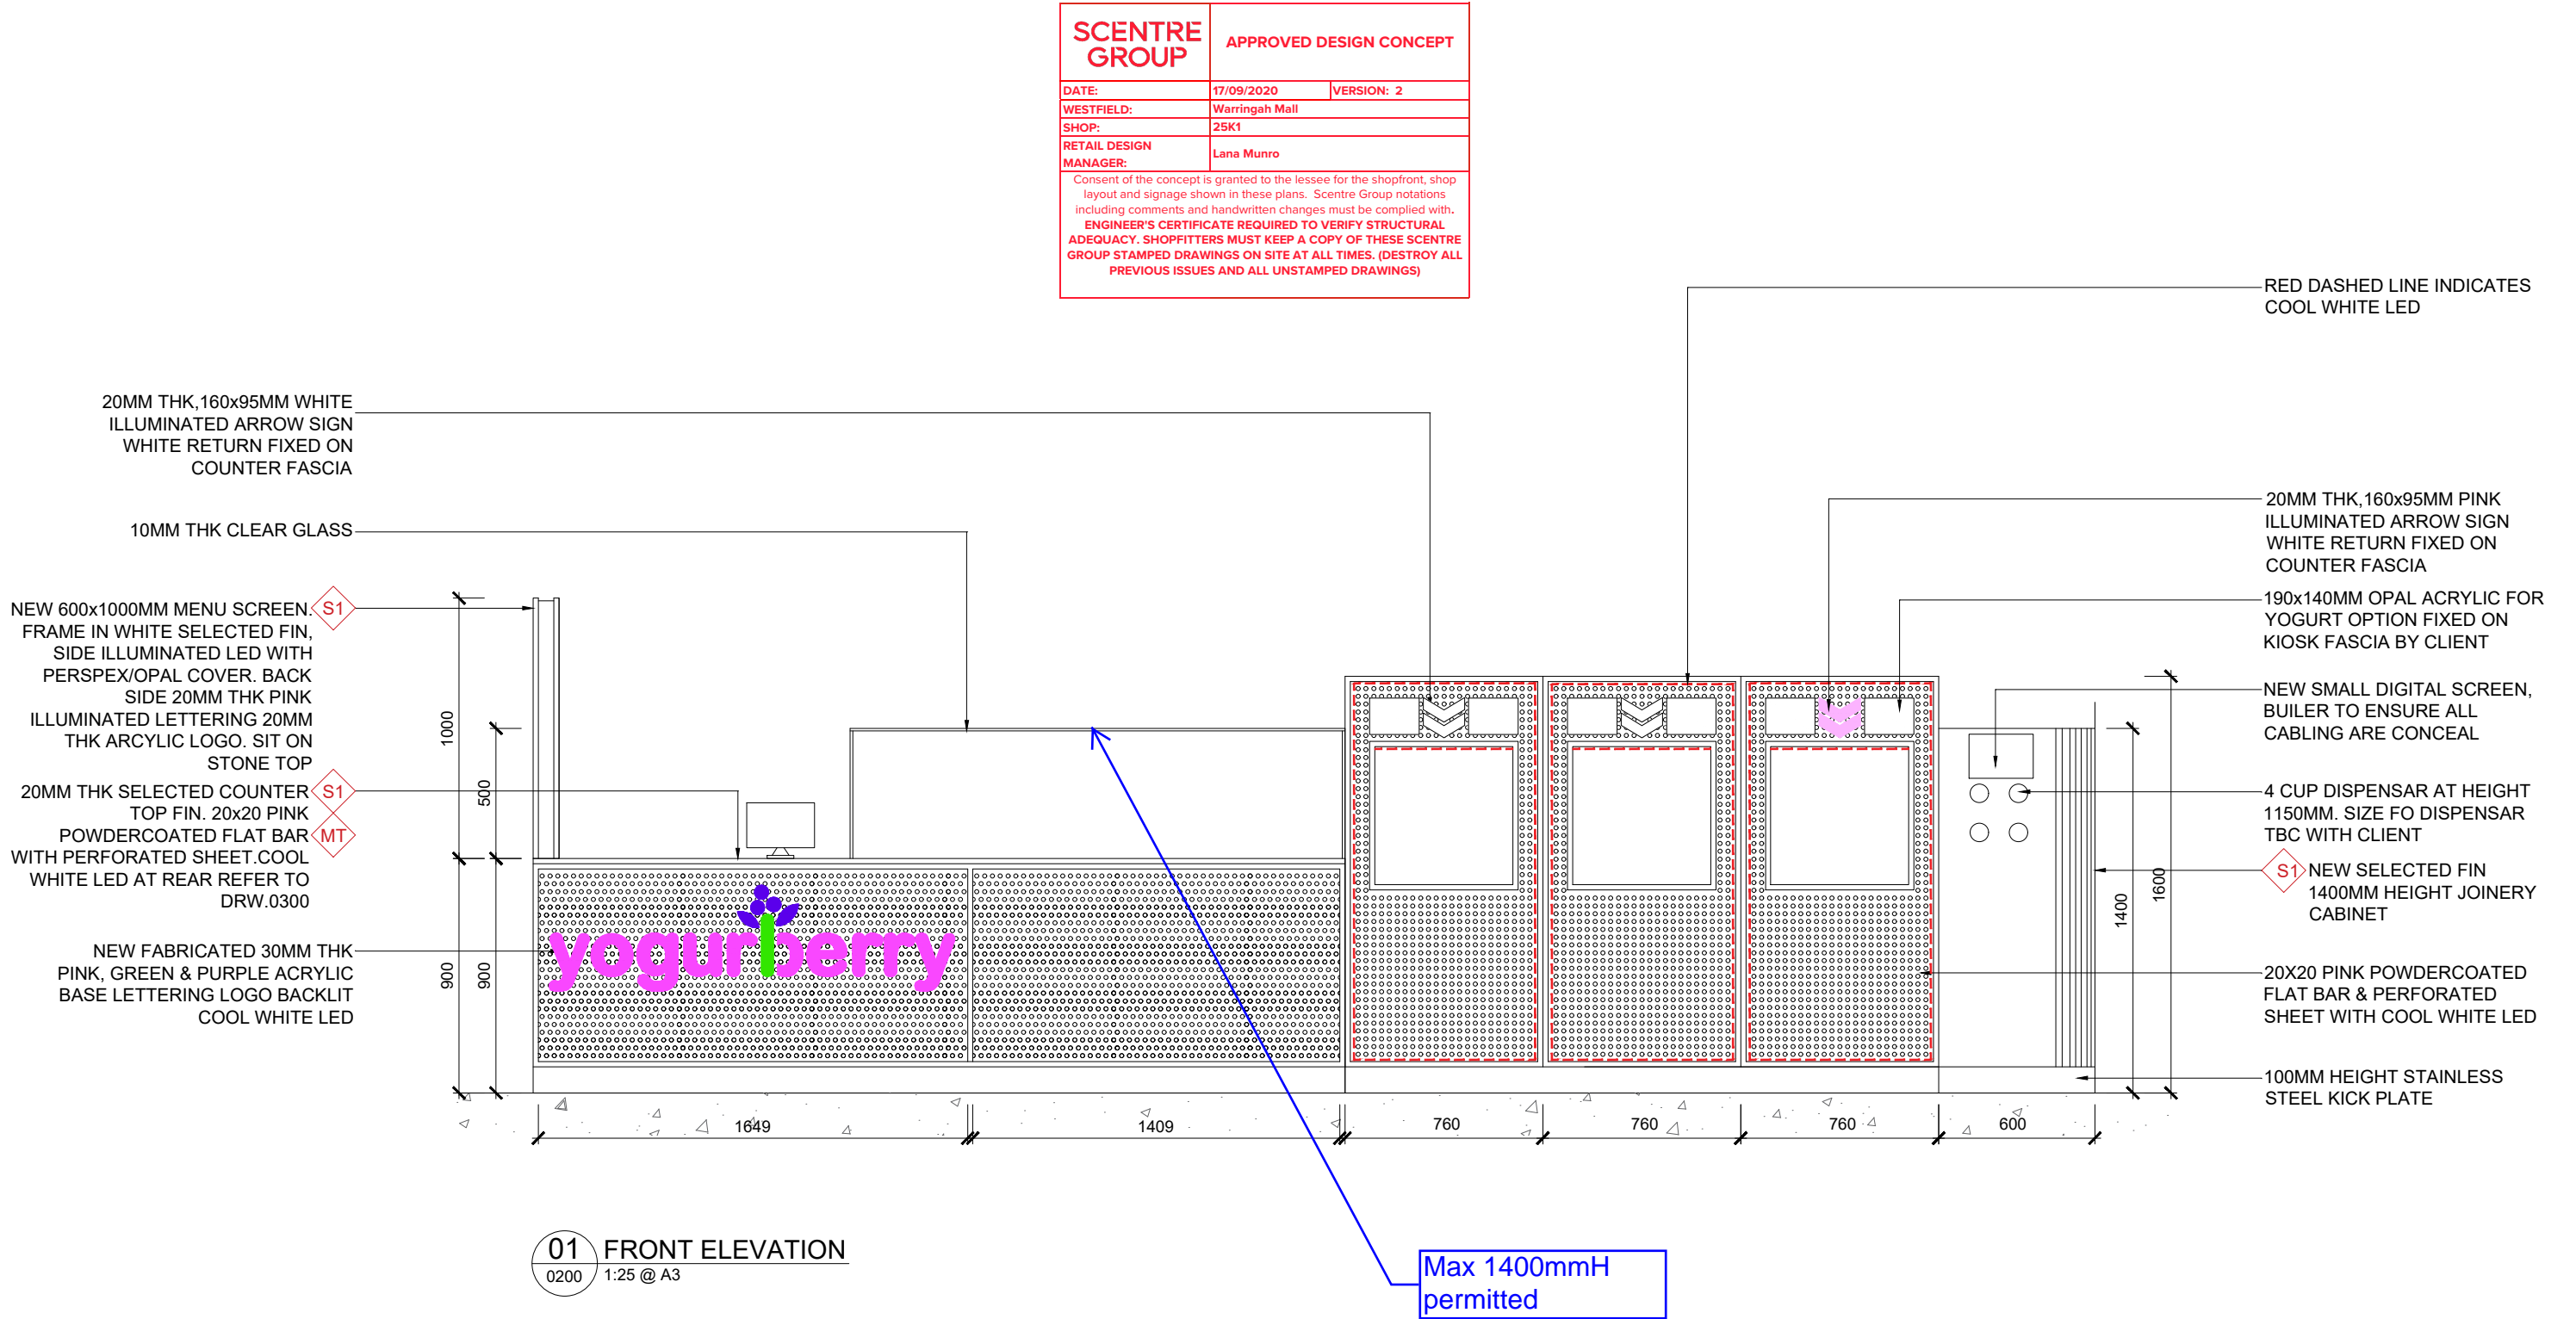

NEW FABRICATED 30MM THK
PINK, GREEN & PURPLE ACRYLIC
BASE LETTERING LOGO BACKLIT
COOL WHITE LED

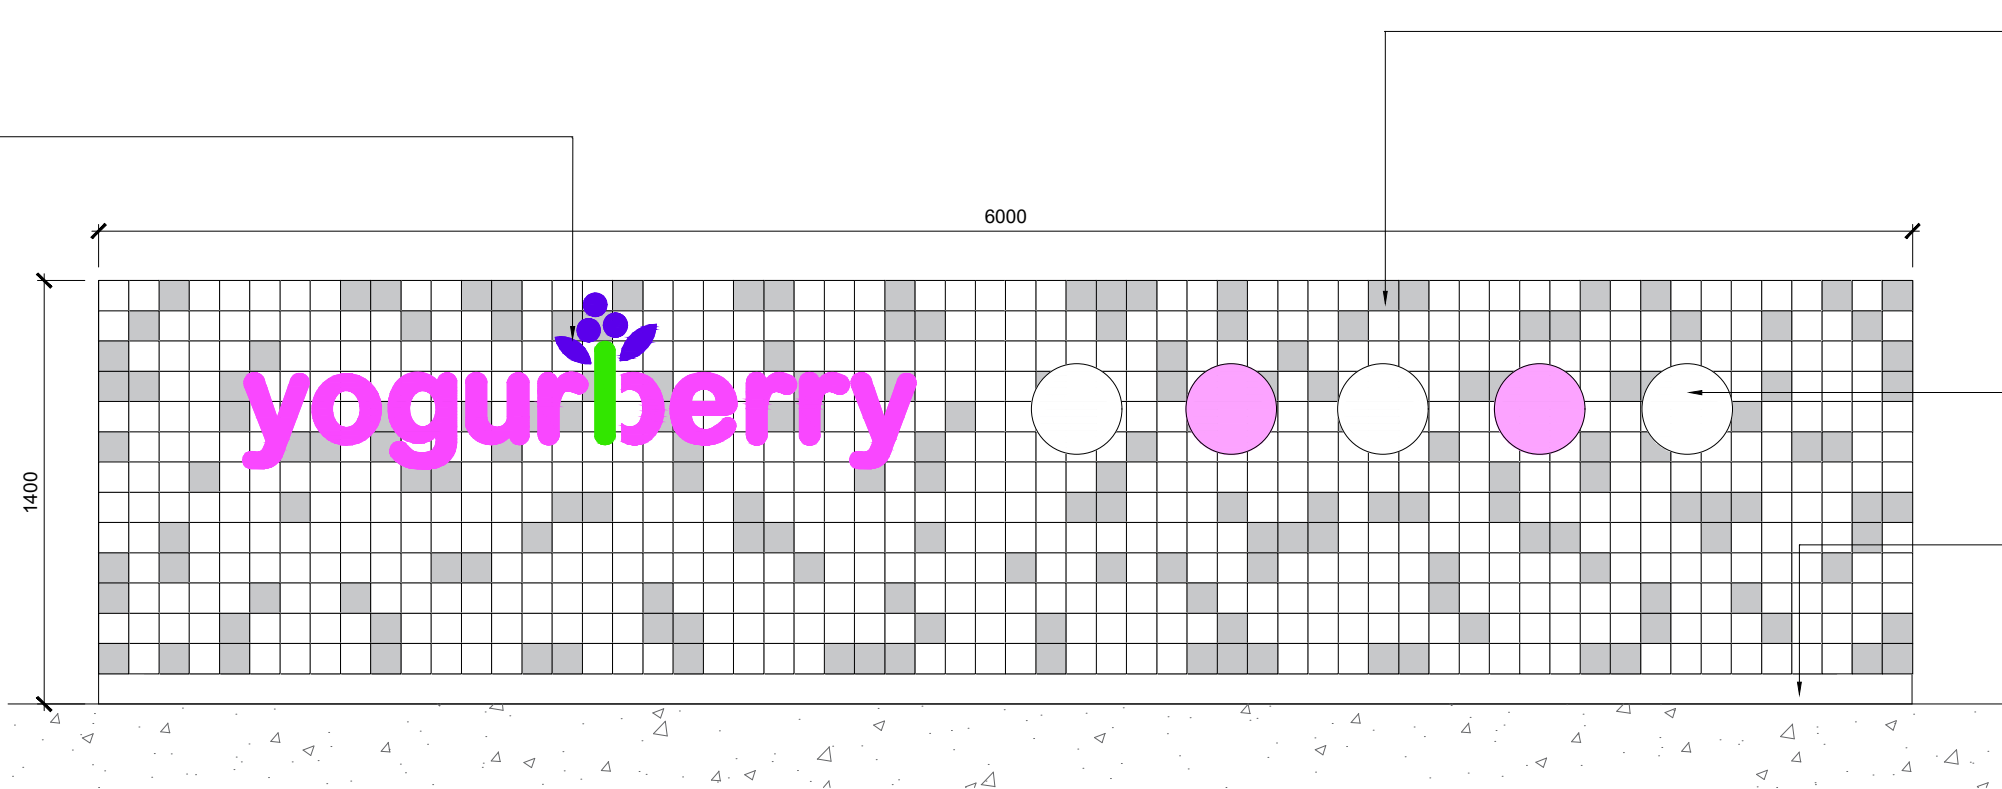


T1 NEW 1400MM HEIGHT WALL
SELECTED TILES FIN WITH
T2 WHITE CAPPING. YOGURTERRY
AND GRAPHIC ILLUMINATED
LOGO REFER TO GRAPHIC
PACKAGE

NEW 30MM THK SELECTED
GRAPHIC. WHITE LED SELF
ILLUMINATED LOGO SIGN
REFER TO GRAPHIC PACKAGE


NEW 100MM HEIGHT
STAINLESS STEEL KICKPLATE


01 REAR ELEVATION
0201 1:25 @ A3

SCENTRE GROUP		APPROVED DESIGN CONCEPT	
DATE:	17/09/2020	VERSION: 2	
WESTFIELD:	Warringah Mall		
SHOP:	25K1		
RETAIL DESIGN MANAGER:	Lana Munro		
<p>Consent of the concept is granted to the lessee for the shopfront, shop layout and signage shown in these plans. Scentre Group notations including comments and handwritten changes must be complied with.</p> <p>ENGINEER'S CERTIFICATE REQUIRED TO VERIFY STRUCTURAL ADEQUACY. SHOPFITTERS MUST KEEP A COPY OF THESE SCENTRE GROUP STAMPED DRAWINGS ON SITE AT ALL TIMES. (DESTROY ALL PREVIOUS ISSUES AND ALL UNSTAMPED DRAWINGS)</p>			


<div><p>suite 42, Level 7, 591 George St, Sydney P (+61 2) 8068 1755 F (+61 2) 9264 8787 joel@liteco.com.au</p></div>	CLIENT	<div>NOTES<ul style="list-style-type: none">All drawings to be read in conjunction with all engineers documentation and specification.Contractor to ensure all new building works, new fittings and fixtures are installed to the current BCA, Australian Standards and Work Cover Regulations.The Contractor shall use figured dimensions in preference to scaled dimensions. All dimensions shall be verified on site by the Contractors prior to commencing any work or preparing shop drawings.All materials are to be used in accordance with manufacturer's specifications and instructions, and to comply with relevant Australian Standards.Partition set-out to be approved by Project Manager on-site prior to construction.COPYRIGHT These drawings and the designs are the property of Liteco project and must not be used, retained or copied without written permission of Liteco project.</div>					TITLE	DRAWING NO.		
	YOGURTBERRY			C	24.08.2020	JC	DESIGN APPROVAL	REAR ELEVATION	0201	
	PROJECT			B	24.08.2020	JC	DESIGN APPROVAL		SCALE 1:25 @ A3	
			WESTFIELD WARRINGAH MALL KIOSK 25K1		A	29.05.2020	JC	DESIGN APPROVAL	DRAWN BY JC	CHECKED JC
				ISSUE	DATE	INITIALS	REVISION DETAIL	CLIENT APPROVAL	ISSUE C	


SCENTRE GROUP		APPROVED DESIGN CONCEPT	
DATE:	17/09/2020	VERSION: 2	
WESTFIELD:	Warringah Mall		
SHOP:	25K1		
RETAIL DESIGN MANAGER:	Lana Munro		
<p>Consent of the concept is granted to the lessee for the shopfront, shop layout and signage shown in these plans. Scentre Group notations including comments and handwritten changes must be complied with.</p> <p>ENGINEER'S CERTIFICATE REQUIRED TO VERIFY STRUCTURAL ADEQUACY. SHOPFITTERS MUST KEEP A COPY OF THESE SCENTRE GROUP STAMPED DRAWINGS ON SITE AT ALL TIMES. (DESTROY ALL PREVIOUS ISSUES AND ALL UNSTAMPED DRAWINGS)</p>			

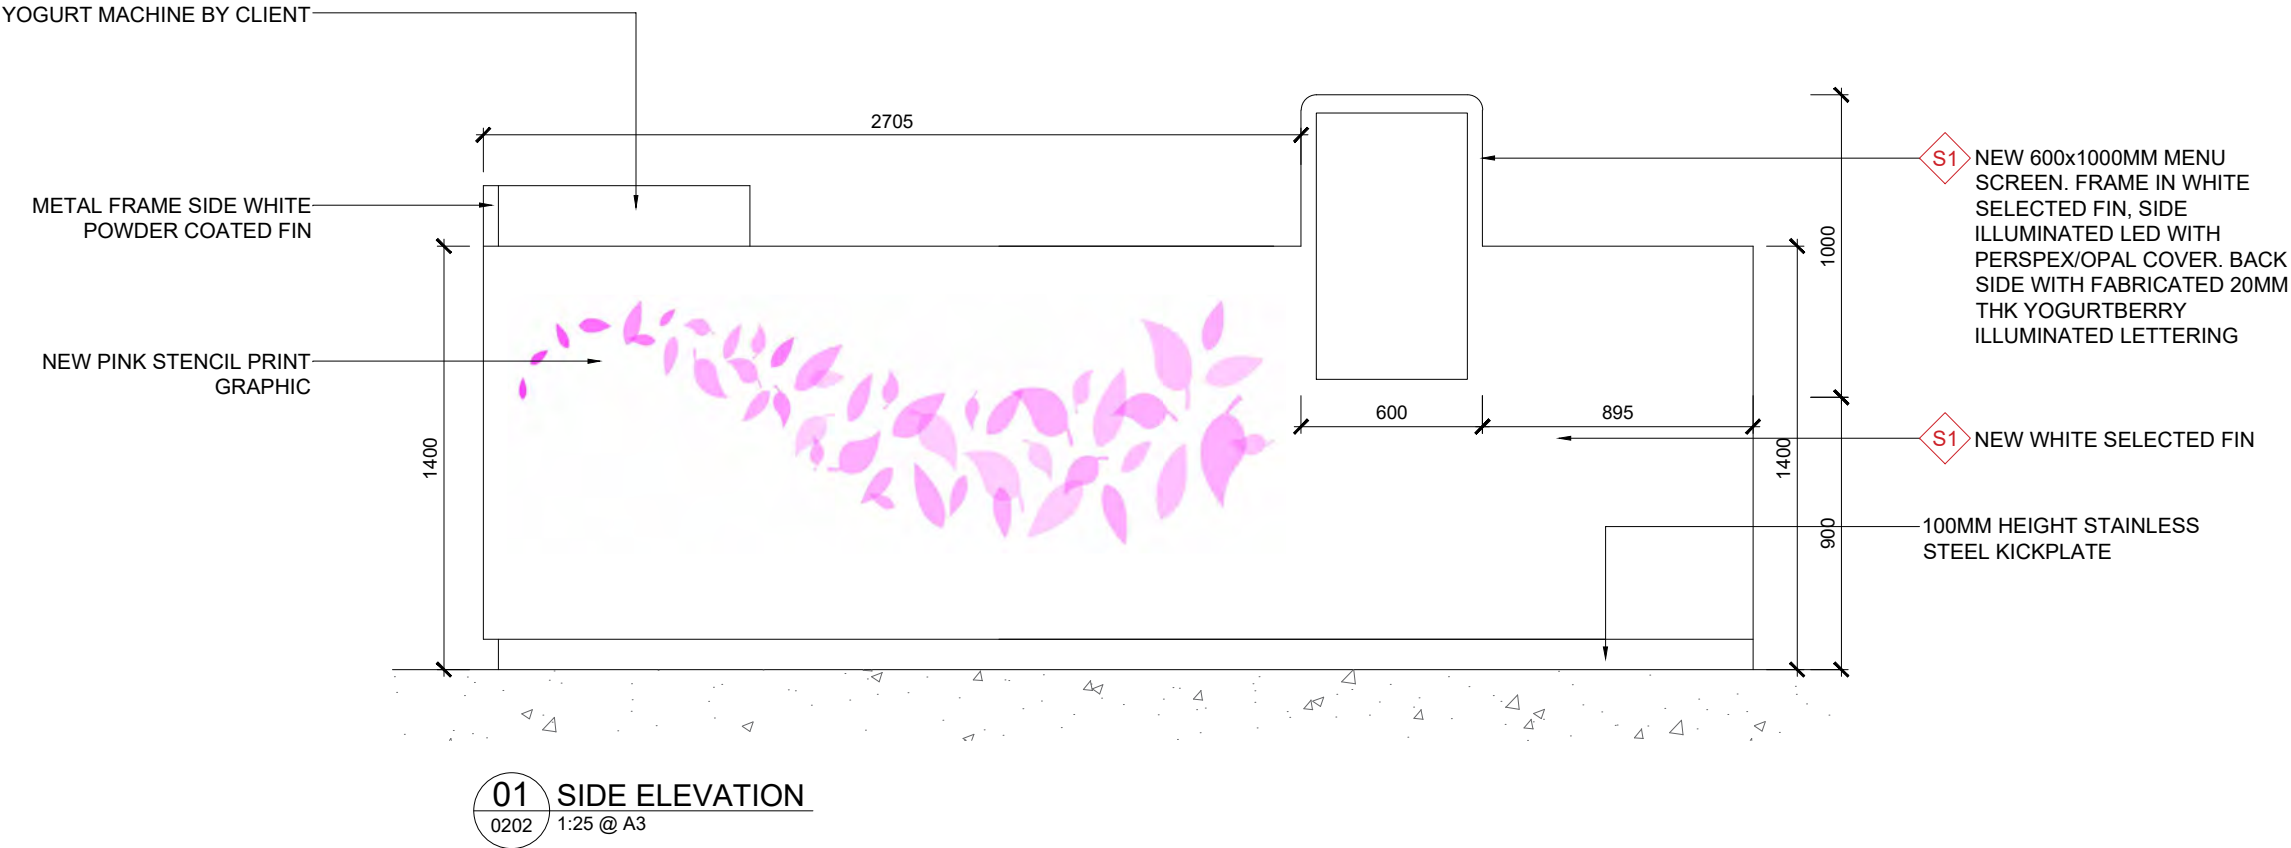


<div></div> <div>suite 42, Level 7, 591 George St, Sydney P (+61 2) 8068 1755 F (+61 2) 9264 8787 joel@liteco.com.au</div>	CLIENT YOGURTBERRY	NOTES <ul style="list-style-type: none">• All drawings to be read in conjunction with all engineers documentation and specification.• Contractor to ensure all new building works, new fittings and fixtures are installed to the current BCA, Australian Standards and Work Cover Regulations.• The Contractor shall use figured dimensions in preference to scaled dimensions. All dimensions shall be verified on site by the Contractors prior to commencing any work or preparing shop drawings.• All materials are to be used in accordance with manufacturer's specifications and instructions, and to comply with relevant Australian Standards.• Partition set-out to be approved by Project Manager on-site prior to construction.• COPYRIGHT These drawings and the designs are the property of Liteco project and must not be used, retained or copied without written permission of Liteco project.	D	11.09.2020	JC	DESIGN APPROVAL	TITLE SIDE ELEVATION	DRAWING NO. 0202
	PROJECT WESTFIELD WARRINGAH MALL KIOSK 25K1		C	02.09.2020	JC	DESIGN APPROVAL		SCALE 1:25 @ A3
			B	24.08.2020	JC	DESIGN APPROVAL		CHECKED JC
			A	29.05.2020	JC	CONSTRUCTION	DRAWN BY JC	ISSUE D
			ISSUE	DATE	INITIALS	REVISION DETAIL	CLIENT APPROVAL	

SCENTRE GROUP		APPROVED DESIGN CONCEPT	
DATE:	17/09/2020	VERSION: 2	
WESTFIELD:	Warringah Mall		
SHOP:	25K1		
RETAIL DESIGN MANAGER:	Lana Munro		
Consent of the concept is granted to the lessee for the shopfront, shop layout and signage shown in these plans. Scentre Group notations including comments and handwritten changes must be complied with.			
ENGINEER'S CERTIFICATE REQUIRED TO VERIFY STRUCTURAL ADEQUACY. SHOPFITTERS MUST KEEP A COPY OF THESE SCENTRE GROUP STAMPED DRAWINGS ON SITE AT ALL TIMES. (DESTROY ALL PREVIOUS ISSUES AND ALL UNSTAMPED DRAWINGS)			

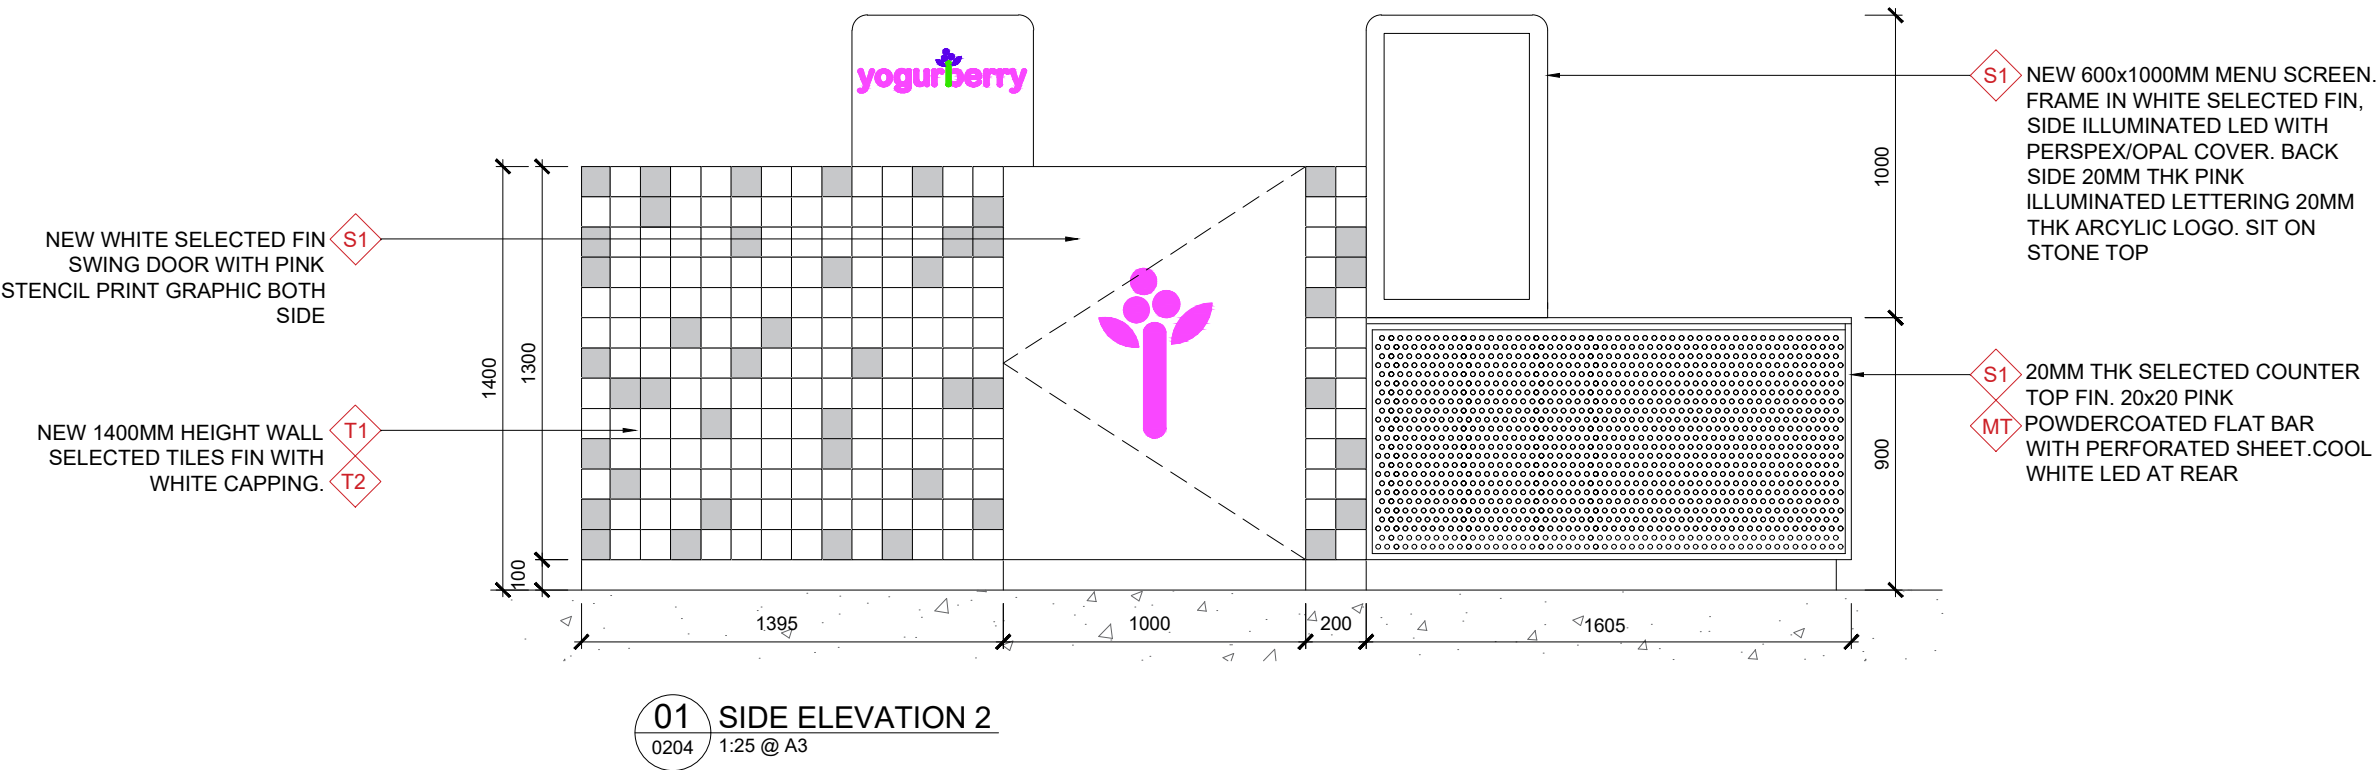

<div></div> <div>suite 42, Level 7, 591 George St, Sydney P (+61 2) 8068 1755 F (+61 2) 9264 8787 joel@liteco.com.au</div>	CLIENT YOGURTBERRY	<div>NOTES</div> <ul style="list-style-type: none">• All drawings to be read in conjunction with all engineers documentation and specification.• Contractor to ensure all new building works, new fittings and fixtures are installed to the current BCA, Australian Standards and Work Cover Regulations.• The Contractor shall use figured dimensions in preference to scaled dimensions. All dimensions shall be verified on site by the Contractors prior to commencing any work or preparing shop drawings.• All materials are to be used in accordance with manufacturer's specifications and instructions, and to comply with relevant Australian Standards.• Partition set-out to be approved by Project Manager on-site prior to construction.• COPYRIGHT These drawings and the designs are the property of Liteco project and must not be used, retained or copied without written permission of Liteco project.	D	11.09.2020	JC	DESIGN APPROVAL	TITLE SIDE ELEVATION 2	DRAWING NO. 0203
	PROJECT WESTFIELD WARRINGAH MALL KIOSK 25K1		C	02.09.2020	JC	DESIGN APPROVAL		SCALE 1:25 @ A3
			B	24.08.2020	JC	DESIGN APPROVAL		CHECKED JC
			A	29.05.2020	JC	DESIGN APPROVAL	DRAWN BY JC	
			ISSUE	DATE	INITIALS	REVISION DETAIL	CLIENT APPROVAL	ISSUE D

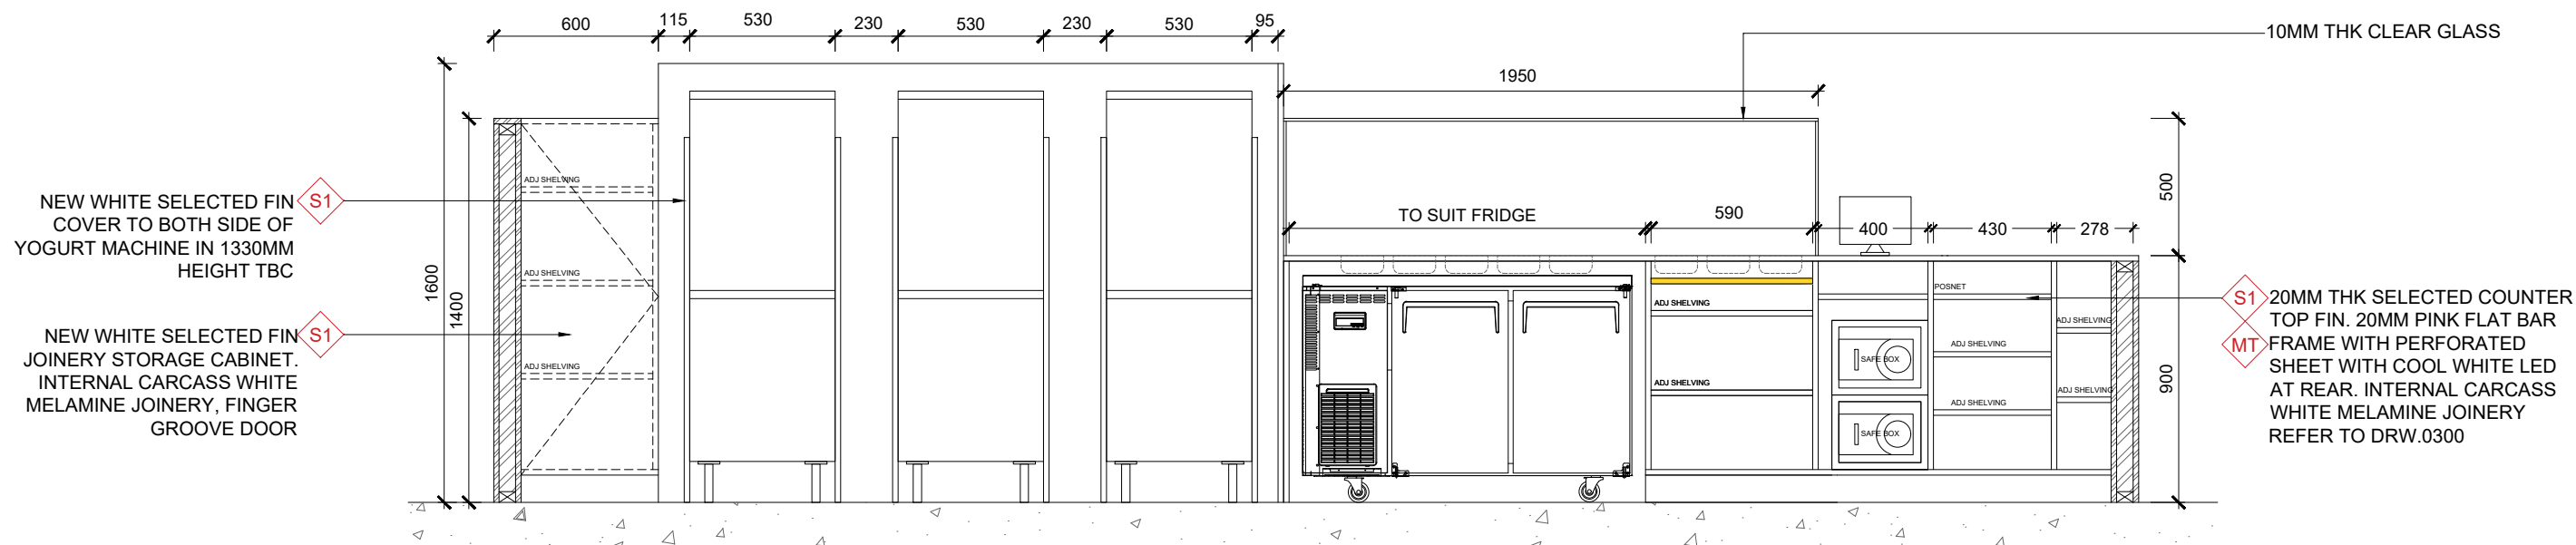


01 INTERNAL ELEVATION 1
0204 1:25 @ A3

SCENTRE GROUP		APPROVED DESIGN CONCEPT
DATE:	17/09/2020	VERSION: 2
WESTFIELD:	Warringah Mall	
SHOP:	25K1	
RETAIL DESIGN MANAGER:	Lana Munro	


Consent of the concept is granted to the lessee for the shopfront, shop layout and signage shown in these plans. Scentre Group notations including comments and handwritten changes must be complied with

ENGINEER'S CERTIFICATE REQUIRED TO VERIFY STRUCTURAL ADEQUACY. SHOP FITTERS MUST KEEP A COPY OF THESE SCENTRE GROUP STAMPED DRAWINGS ON SITE AT ALL TIMES. (DESTROY ALL PREVIOUS ISSUES AND ALL UNSTAMPED DRAWINGS)

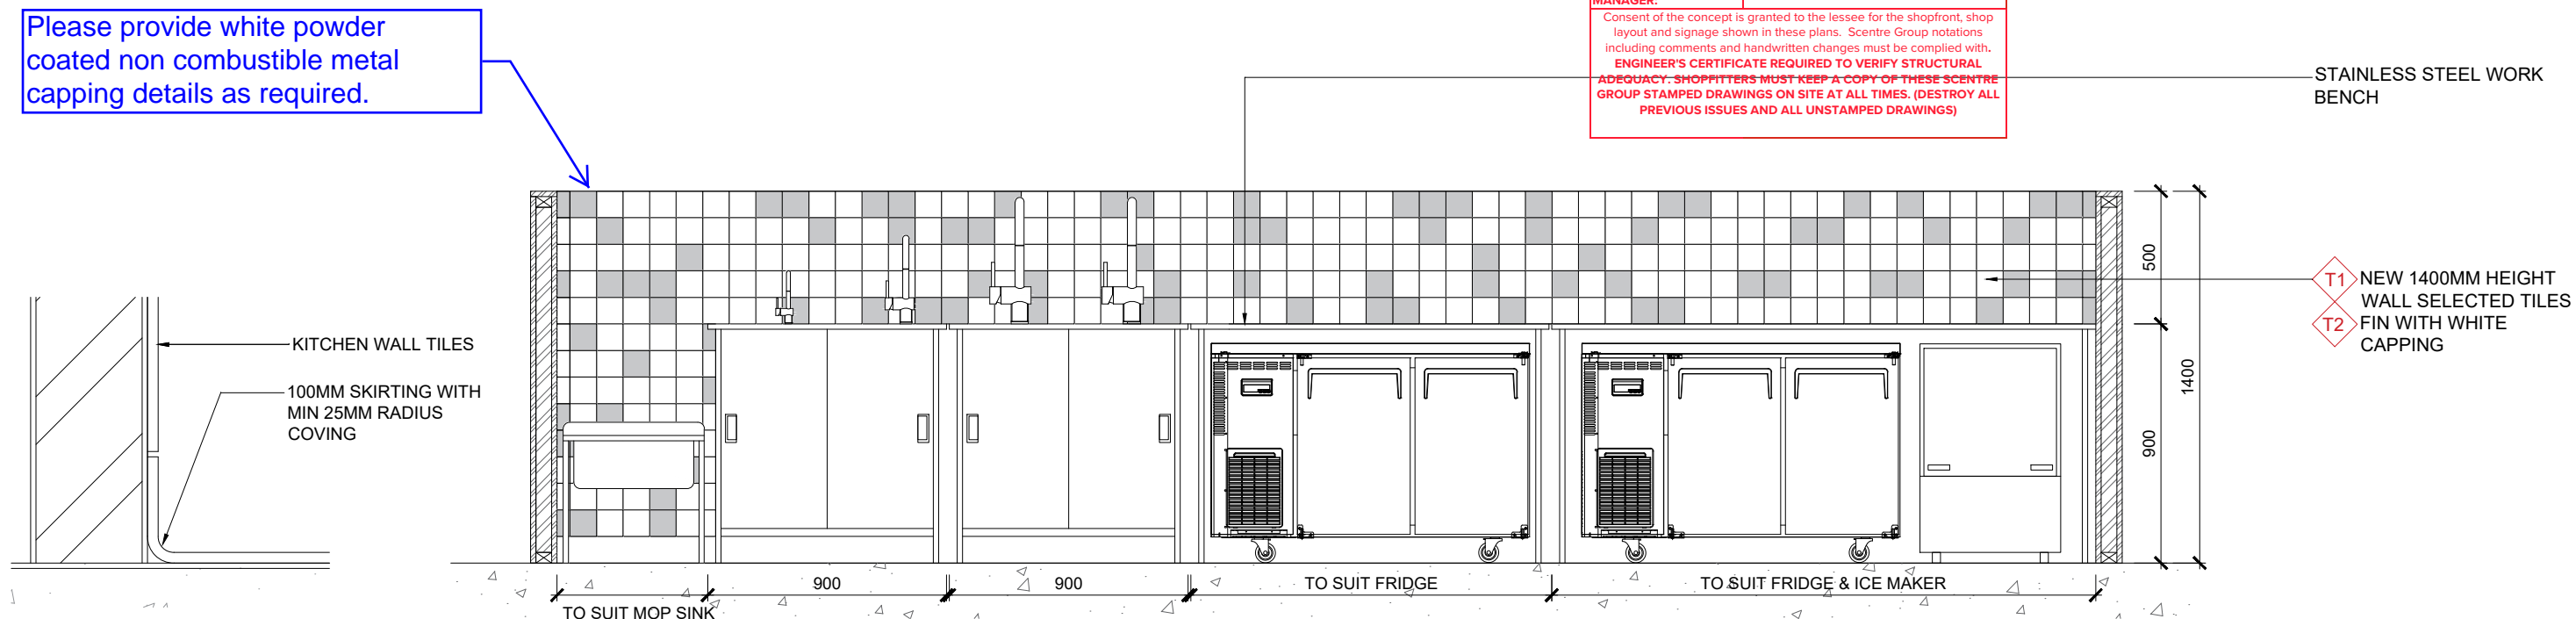


03 COVING DETAILS
0204 1:10 @ A3


02 INTERNAL ELEVATION 2
0204 1:25 @ A3

<div></div> <div>suite 42, Level 7, 591 George St, Sydney P (+61 2) 8068 1755 F (+61 2) 9264 8787 joel@liteco.com.au</div>	CLIENT YOGURTBERRY	<div>NOTES</div> <ul style="list-style-type: none">• All drawings to be read in conjunction with all engineers documentation and specification.• Contractor to ensure all new building works, new fittings and fixtures are installed to the current BCA, Australian Standards and Work Cover Regulations.• The Contractor shall use figured dimensions in preference to scaled dimensions. All dimensions shall be verified on site by the Contractors prior to commencing any work or preparing shop drawings.• All materials are to be used in accordance with manufacturer's specifications and instructions, and to comply with relevant Australian Standards.• Partition set-out to be approved by Project Manager on-site prior to construction.• COPYRIGHT These drawings and the designs are the property of Liteco project and must not be used, retained or copied without written permission of Liteco project.	D	11.09.2020	JC	DESIGN APPROVAL	TITLE INTERNAL ELEVATION	DRAWING NO. 0204
	PROJECT WESTFIELD WARRINGAH MALL KIOSK 25K1		C	02.09.2020	JC	DESIGN APPROVAL		SCALE 1:25 @ A3
			B	24.08.2020	JC	DESIGN APPROVAL		
			A	29.05.2020	JC	DESIGN APPROVAL	DRAWN BY JC	CHECKED JC
			ISSUE	DATE	INITIALS	REVISION DETAIL	CLIENT APPROVAL	ISSUE D


SCENTRE GROUP		APPROVED DESIGN CONCEPT	
DATE:	17/09/2020	VERSION: 2	
WESTFIELD:	Warringah Mall		
SHOP:	25K1		
RETAIL DESIGN MANAGER:	Lana Munro		
<p>Consent of the concept is granted to the lessee for the shopfront, shop layout and signage shown in these plans. Scentre Group notations including comments and handwritten changes must be complied with.</p> <p>ENGINEER'S CERTIFICATE REQUIRED TO VERIFY STRUCTURAL ADEQUACY. SHOPFITTERS MUST KEEP A COPY OF THESE SCENTRE GROUP STAMPED DRAWINGS ON SITE AT ALL TIMES. (DESTROY ALL PREVIOUS ISSUES AND ALL UNSTAMPED DRAWINGS)</p>			

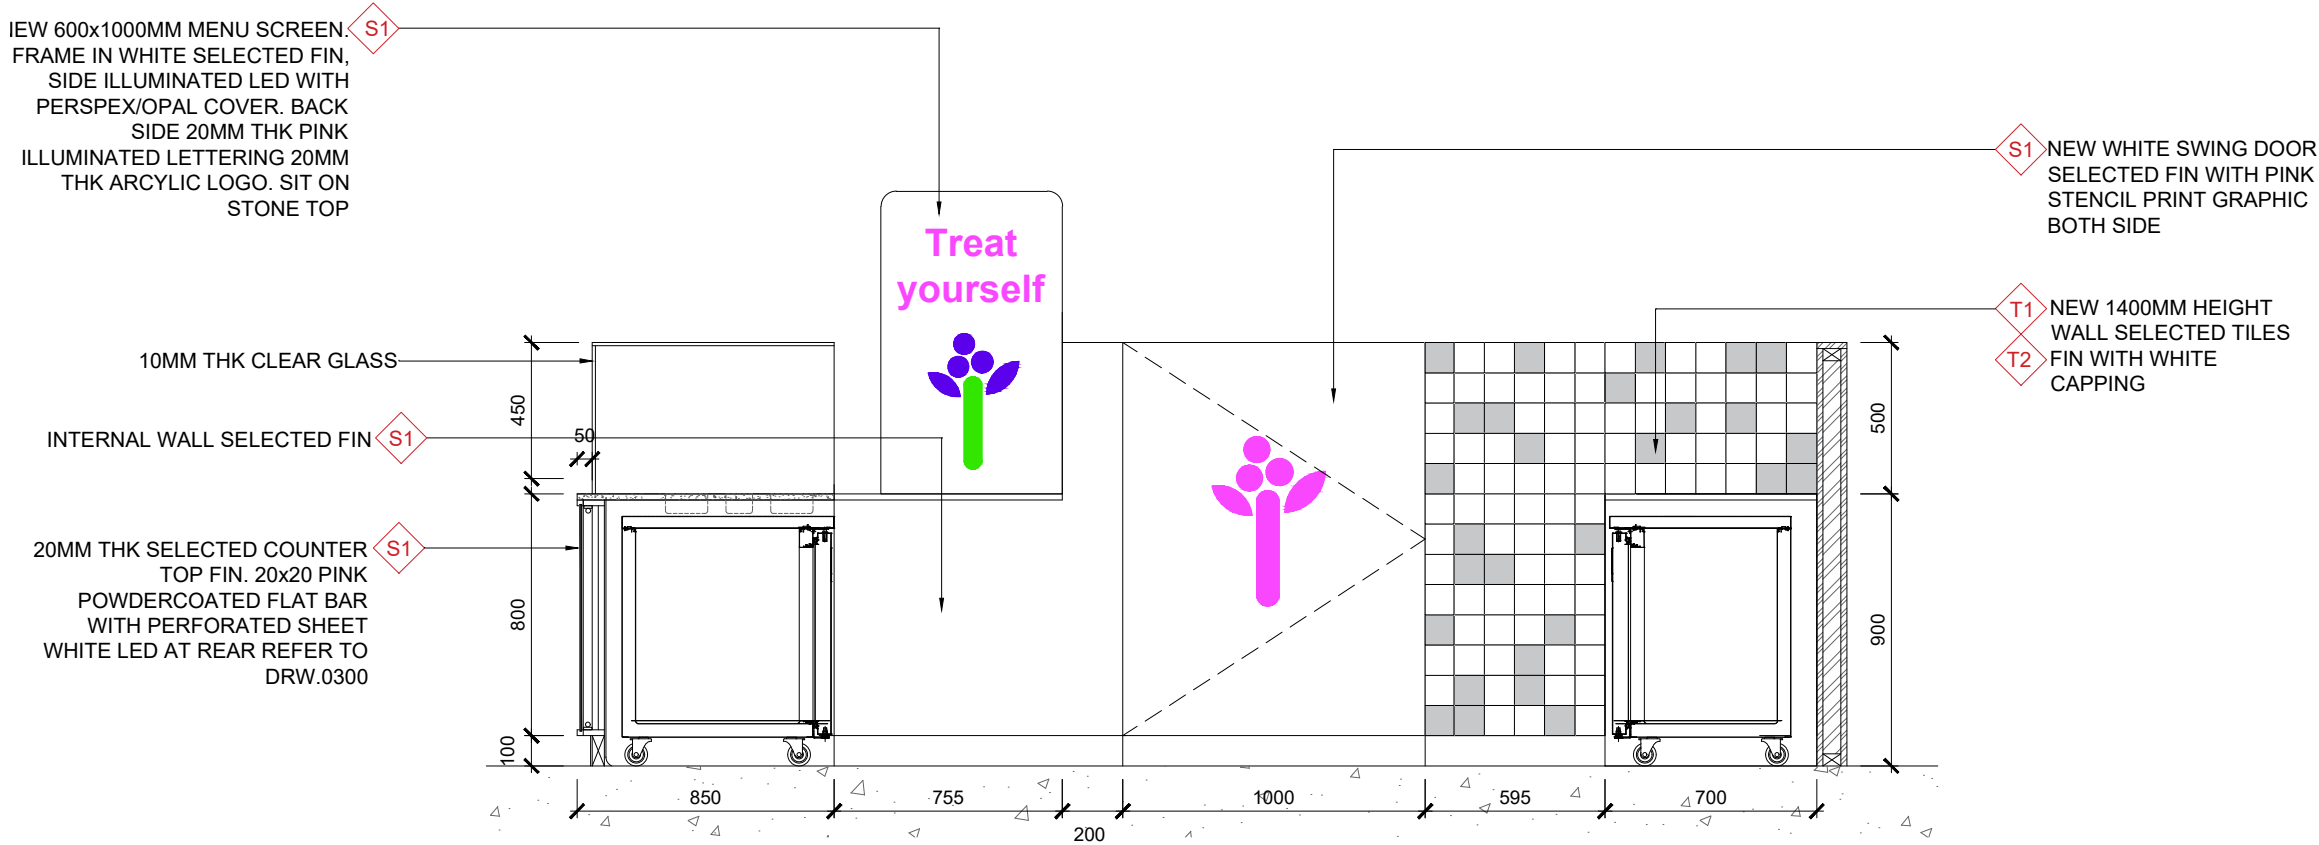

01 INTERNAL SIDE ELEVATION
0205 1:25 @ A3

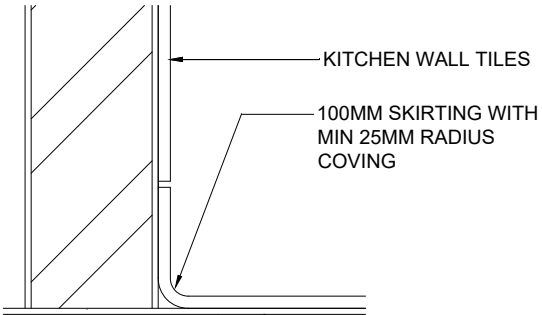

02 COVING DETAILS
0205 1:10 @ A3

<div></div> <div>suite 42, Level 7, 591 George St, Sydney P (+61 2) 8068 1755 F (+61 2) 9264 8787 joel@liteco.com.au</div>	CLIENT YOGURTBERRY	<div>NOTES</div> <ul style="list-style-type: none">• All drawings to be read in conjunction with all engineers documentation and specification.• Contractor to ensure all new building works, new fittings and fixtures are installed to the current BCA, Australian Standards and Work Cover Regulations.• The Contractor shall use figured dimensions in preference to scaled dimensions. All dimensions shall be verified on site by the Contractors prior to commencing any work or preparing shop drawings.• All materials are to be used in accordance with manufacturer's specifications and instructions, and to comply with relevant Australian Standards.• Partition set-out to be approved by Project Manager on-site prior to construction.• COPYRIGHT These drawings and the designs are the property of Liteco project and must not be used, retained or copied without written permission of Liteco project.	D	11.09.2020	JC	DESIGN APPROVAL	TITLE INTERNAL ELEVATION 2	DRAWING NO. 0205
	PROJECT WESTFIELD WARRINGAH MALL KIOSK 25K1		C	02.09.2020	JC	DESIGN APPROVAL		SCALE 1:25 @ A3
			B	24.08.2020	JC	DESIGN APPROVAL		CHECKED JC
			A	29.05.2020	JC	DESIGN APPROVAL	ISSUE D	
			ISSUE	DATE	INITIALS	REVISION DETAIL	CLIENT APPROVAL	


SCENTRE GROUP		APPROVED DESIGN CONCEPT	
DATE:	17/09/2020	VERSION:	2
WESTFIELD:	Warringah Mall		
SHOP:	25K1		
RETAIL DESIGN	Lana Munro		
MANAGER:			
Consent of the concept is granted to the lessee for the shopfront, shop layout and signage shown in these plans. Scentre Group notations including comments and handwritten changes must be complied with.			
ENGINEER'S CERTIFICATE REQUIRED TO VERIFY STRUCTURAL ADEQUACY. SHOPFITTERS MUST KEEP A COPY OF THESE SCENTRE GROUP STAMPED DRAWINGS ON SITE AT ALL TIMES. (DESTROY ALL PREVIOUS ISSUES AND ALL UNSTAMPED DRAWINGS)			

Please provide white powder coated non combustible metal capping details as required.

NEW WHITE SELECTED FIN JOINERY CABINET. FINGER GROOVE DOOR REFER TO DRW.0304

NEW 600x1000MM MENU SCREEN SELECTED FIN. SIDE WHITE LED WITH PERSPEX/OPAL COVER. BACK SIDE WITH FABRICATED 558x145MM, 20MM THK ILLUMINATED YOGURT BERRY LETTERING

NEW 1400MM HEIGHT WALL SELECTED TILES FIN WITH WHITE CAPPING

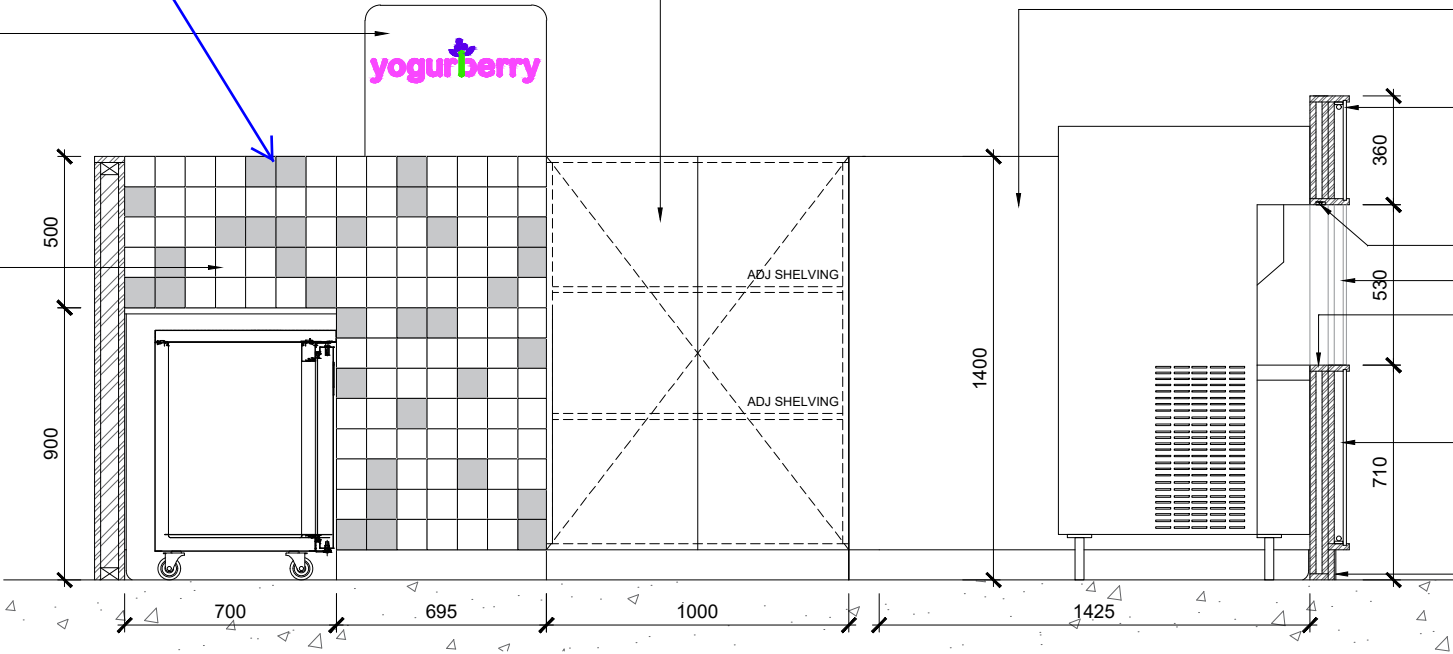

01 INTRENAL SIDE ELEVATION 2
0206 1:25 @ A3

S1 INTERNAL WALL SELECTED FIN

MT 20X20 PINK POWDERCOATED FLAT BAR. PINK POWDERCOATED PERFORATED SHEET WITH COOL WHITE LED


CONCEALED LED LIGHT

OPENING


SURFACE TO BE IN STAINLESS STEEL FIN. BUILDER TO ENSURE NO GAP BETWEEN JOINERY AND MACHINE


MT 20X20 PINK POWDERCOATED FLAT BAR. PINK POWDERCOATED PERFORATED SHEET WITH COOL WHITE LED

100MM HEIGHT STAINLESS STEEL KICKPLATE

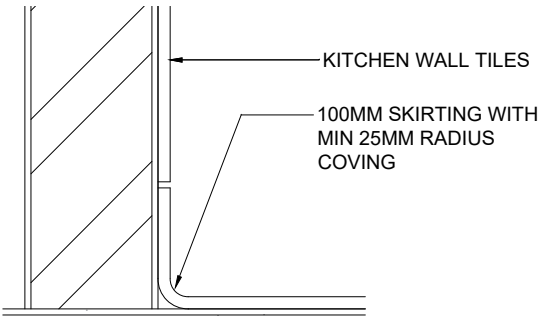

02 COVING DETAILS
0205 1:10 @ A3



<div><p>suite 42, Level 7, 591 George St, Sydney P (+61 2) 8068 1755 F (+61 2) 9264 8787 joel@liteco.com.au</p></div>	CLIENT YOGURT BERRY	NOTES <ul style="list-style-type: none">All drawings to be read in conjunction with all engineers documentation and specification.Contractor to ensure all new building works, new fittings and fixtures are installed to the current BCA, Australian Standards and Work Cover Regulations.The Contractor shall use figured dimensions in preference to scaled dimensions. All dimensions shall be verified on site by the Contractors prior to commencing any work or preparing shop drawings.All materials are to be used in accordance with manufacturer's specifications and instructions, and to comply with relevant Australian Standards.Partition set-out to be approved by Project Manager on-site prior to construction.COPYRIGHT These drawings and the designs are the property of Liteco project and must not be used, retained or copied without written permission of Liteco project.				TITLE	DRAWING NO.
	PROJECT WESTFIELD WARRINGAH MALL KIOSK 25K1		C	11.09.2020	JC	DESIGN APPROVAL	0206
			B	24.08.2020	JC	DESIGN APPROVAL	SCALE 1:25 @ A3
			A	29.05.2020	JC	DESIGN APPROVAL	CHECKED JC
			ISSUE	DATE	INITIALS	REVISION DETAIL	ISSUE C
						CLIENT APPROVAL	
						INTERNAL ELEVATION 3	

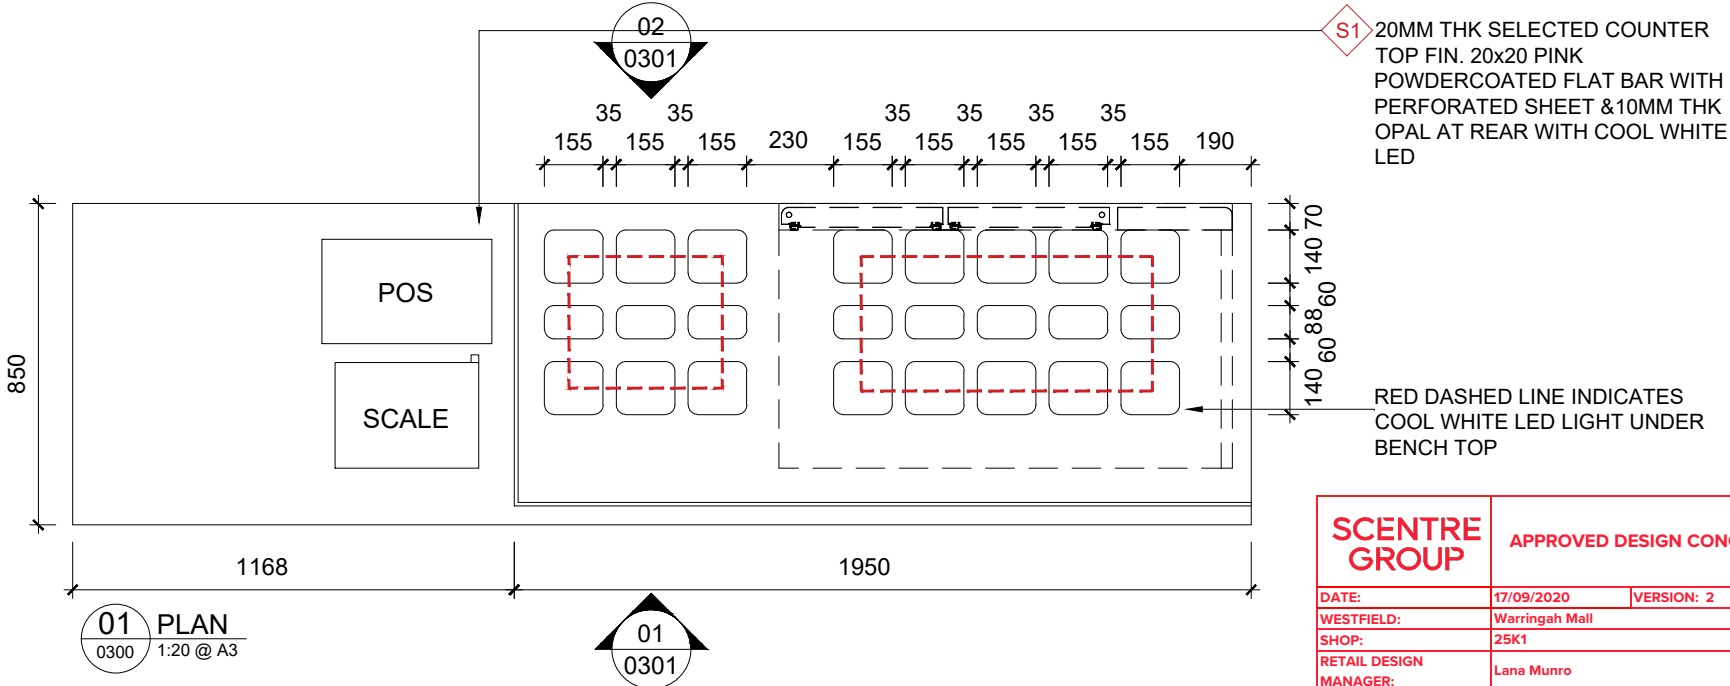


NOTE:
BUILDER TO ENSURE STRUCTURAL INTEGRITY OF JOINERY

SCENTRE GROUP		APPROVED DESIGN CONCEPT	
DATE:	17/09/2020	VERSION: 2	
WESTFIELD:	Warringah Mall		
SHOP:	25K1		
RETAIL DESIGN MANAGER:	Lana Munro		
<p>Consent of the concept is granted to the lessee for the shopfront, shop layout and signage shown in these plans. Scentre Group notations including comments and handwritten changes must be complied with.</p> <p>ENGINEER'S CERTIFICATE REQUIRED TO VERIFY STRUCTURAL ADEQUACY. SHOPFITTERS MUST KEEP A COPY OF THESE SCENTRE GROUP STAMPED DRAWINGS ON SITE AT ALL TIMES. (DESTROY ALL PREVIOUS ISSUES AND ALL UNSTAMPED DRAWINGS)</p>			


NOTE:
JOINERY DRAWINGS SUBJECT TO SHOPDRAWINGS APPROVAL
BUILDER TO ENSURE STRUCTURAL INTEGRITY OF JOINERY

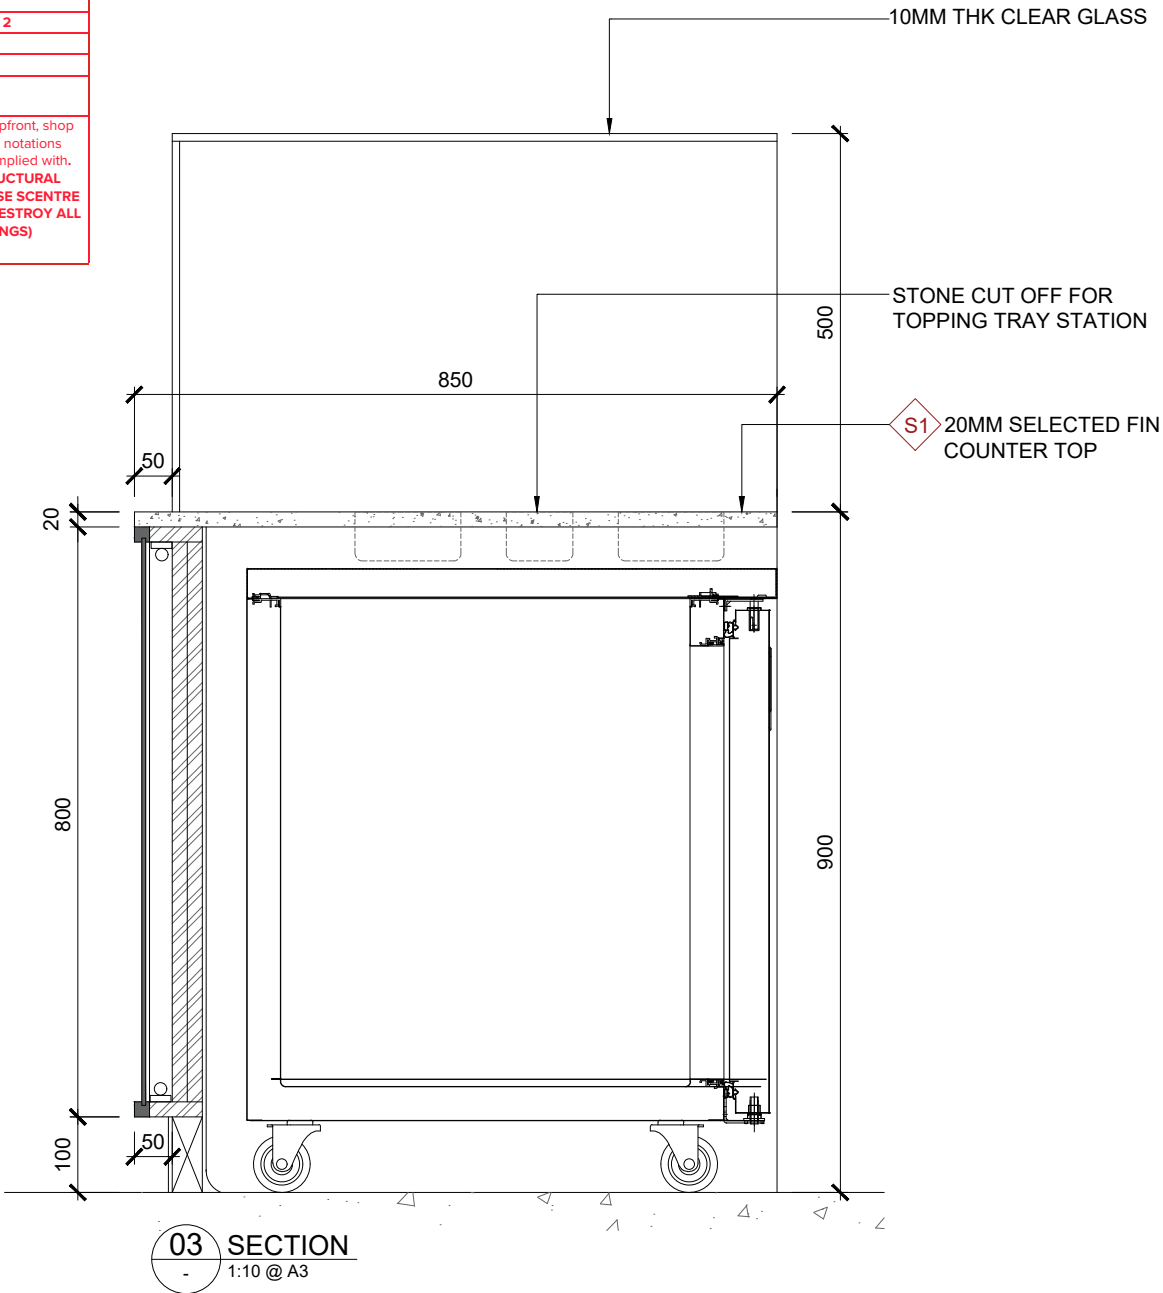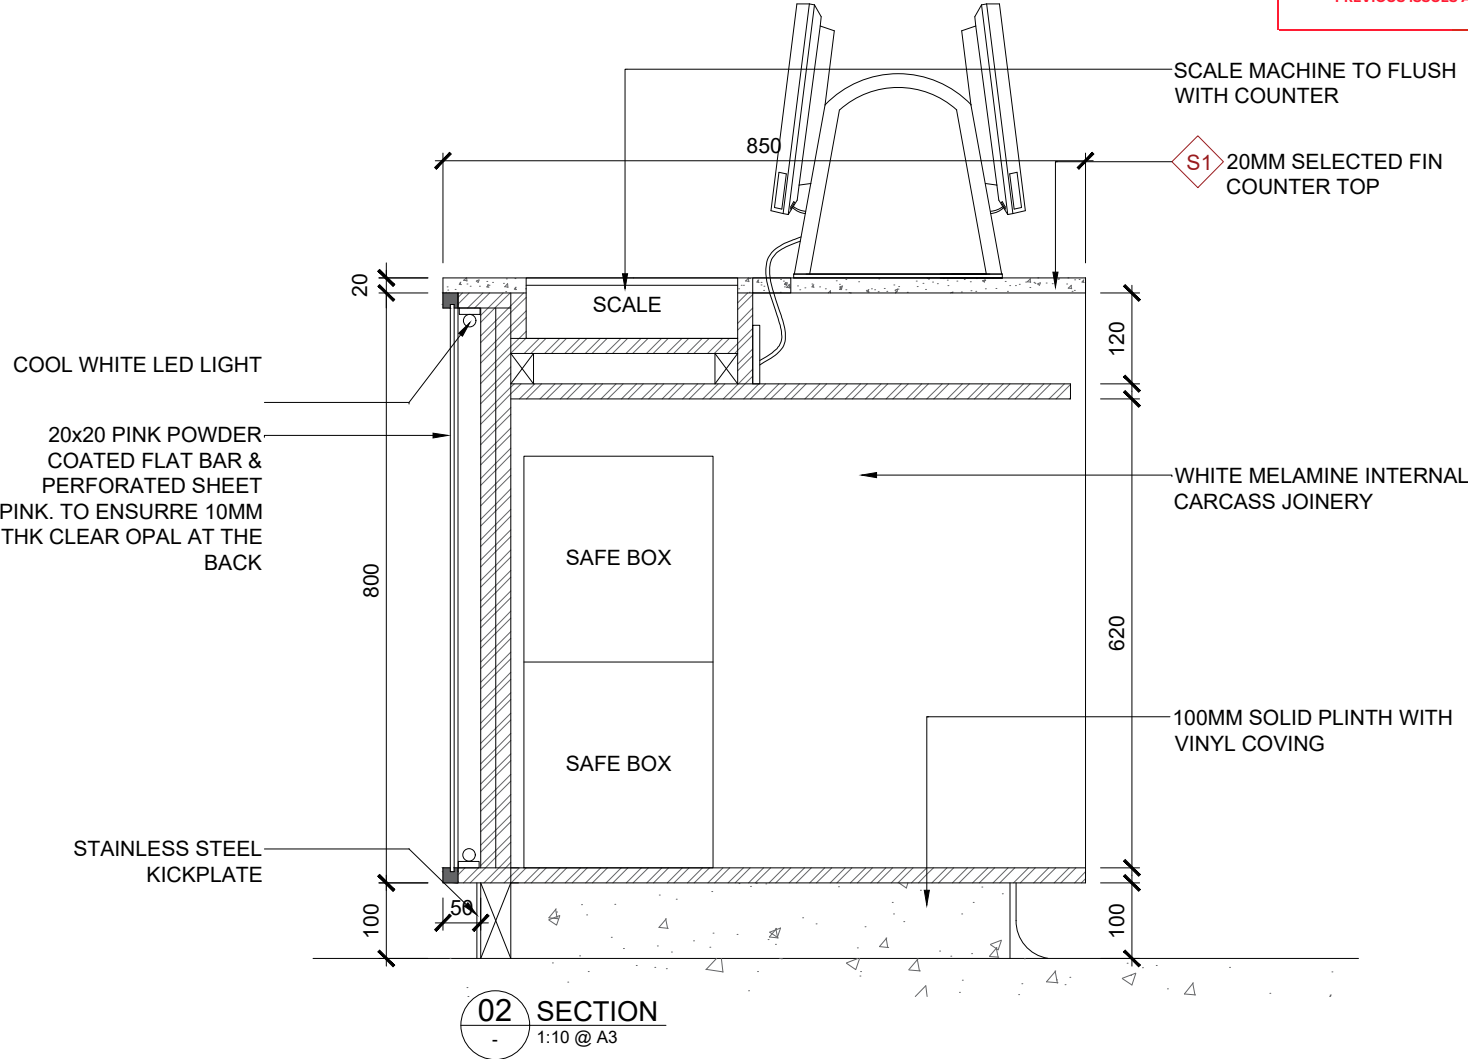


<div></div> <div>suite 42, Level 7, 591 George St, Sydney P (+61 2) 8068 1755 F (+61 2) 9264 8787 joel@liteco.com.au</div>	CLIENT	<div>NOTES</div> <ul style="list-style-type: none">• All drawings to be read in conjunction with all engineers documentation and specification.• Contractor to ensure all new building works, new fittings and fixtures are installed to the current BCA, Australian Standards and Work Cover Regulations.• The Contractor shall use figured dimensions in preference to scaled dimensions. All dimensions shall be verified on site by the Contractors prior to commencing any work or preparing shop drawings.• All materials are to be used in accordance with manufacturer's specifications and instructions, and to comply with relevant Australian Standards.• Partition set-out to be approved by Project Manager on-site prior to construction.• COPYRIGHT These drawings and the designs are the property of Liteco project and must not be used, retained or copied without written permission of Liteco project.					TITLE	DRAWING NO.	
	YOGURTBERRY			C	02.09.2020	JC	DESIGN APPROVAL	COUNTER FRONT DETAIL	0300
	PROJECT			B	24.08.2020	JC	DESIGN APPROVAL		SCALE 1:20 @ A3
	WESTFIELD WARRINGAH MALL KIOSK 25K1			A	29.05.2020	JC	DESIGN APPROVAL	DRAWN BY JC	CHECKED JC
				ISSUE	DATE	INITIALS	REVISION DETAIL	CLIENT APPROVAL	ISSUE C


NOTE:
JOINERY DRAWINGS SUBJECT TO SHOPDRAWINGS APPROVAL

BUILDER TO ENSURE STRUCTURAL INTEGRITY OF JOINERY

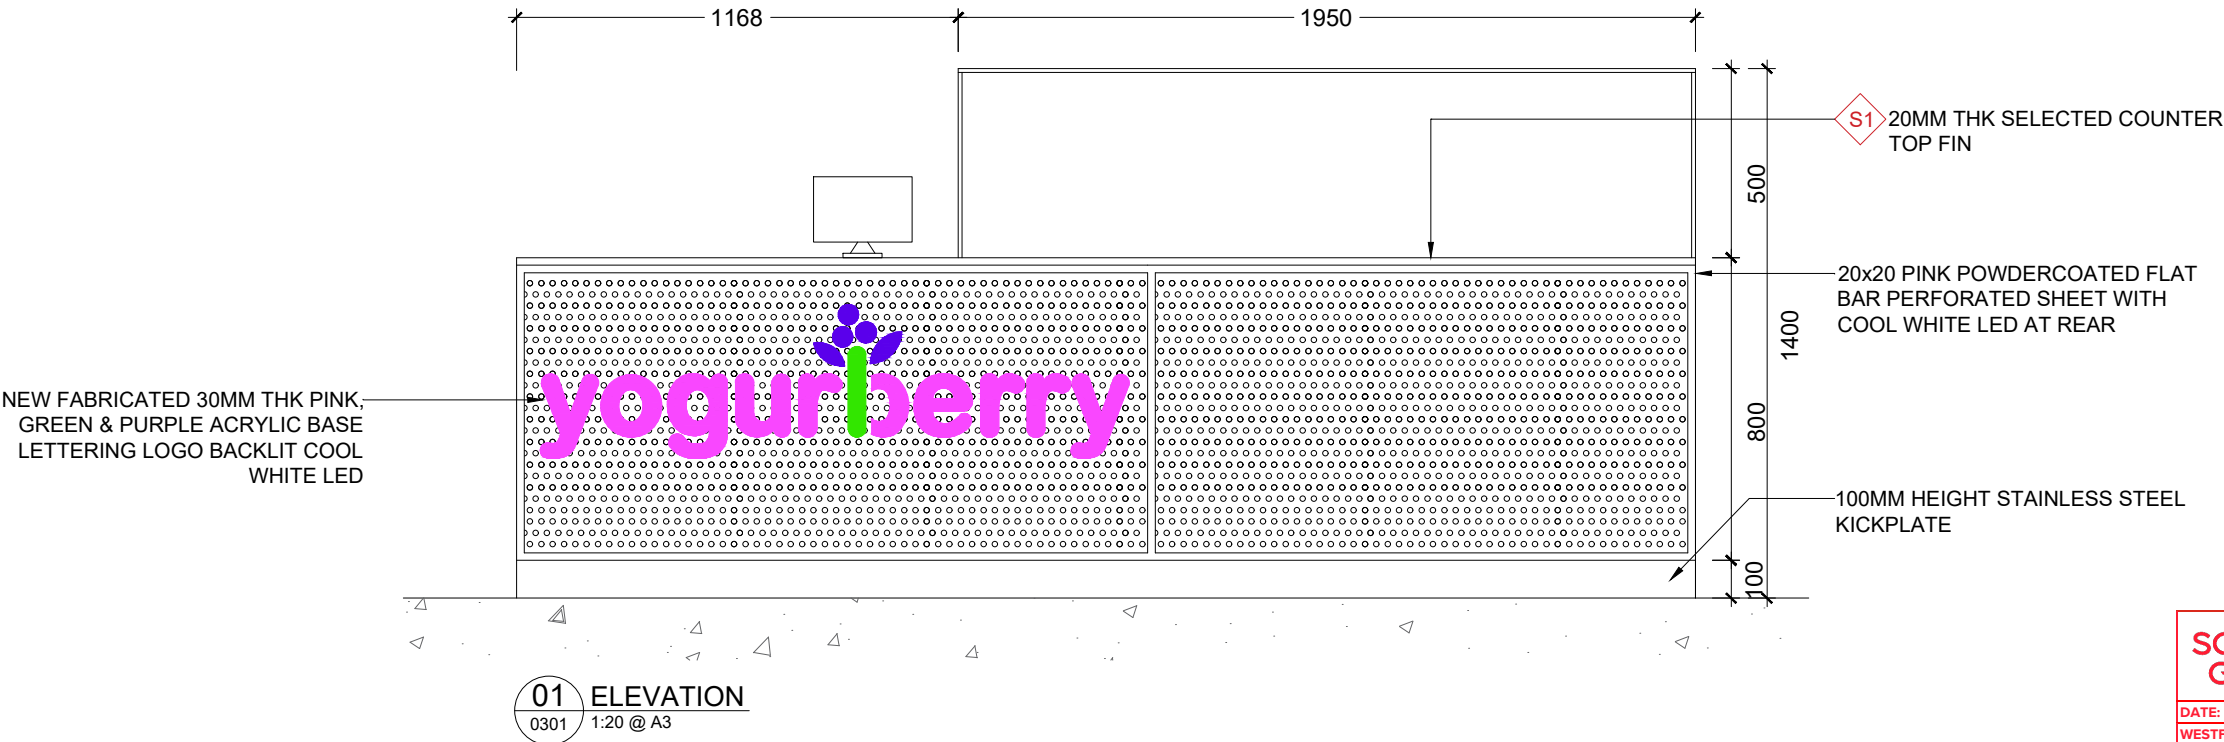


SCENTRE GROUP		APPROVED DESIGN CONCEPT	
DATE:	17/09/2020	VERSION: 2	
WESTFIELD:	Warringah Mall		
SHOP:	25K1		
RETAIL DESIGN MANAGER:	Lana Munro		
Consent of the concept is granted to the lessee for the shopfront, shop layout and signage shown in these plans. Scentre Group notations including comments and handwritten changes must be complied with. ENGINEER'S CERTIFICATE REQUIRED TO VERIFY STRUCTURAL ADEQUACY. SHOPFITTERS MUST KEEP A COPY OF THESE SCENTRE GROUP STAMPED DRAWINGS ON SITE AT ALL TIMES. (DESTROY ALL PREVIOUS ISSUES AND ALL UNSTAMPED DRAWINGS)			

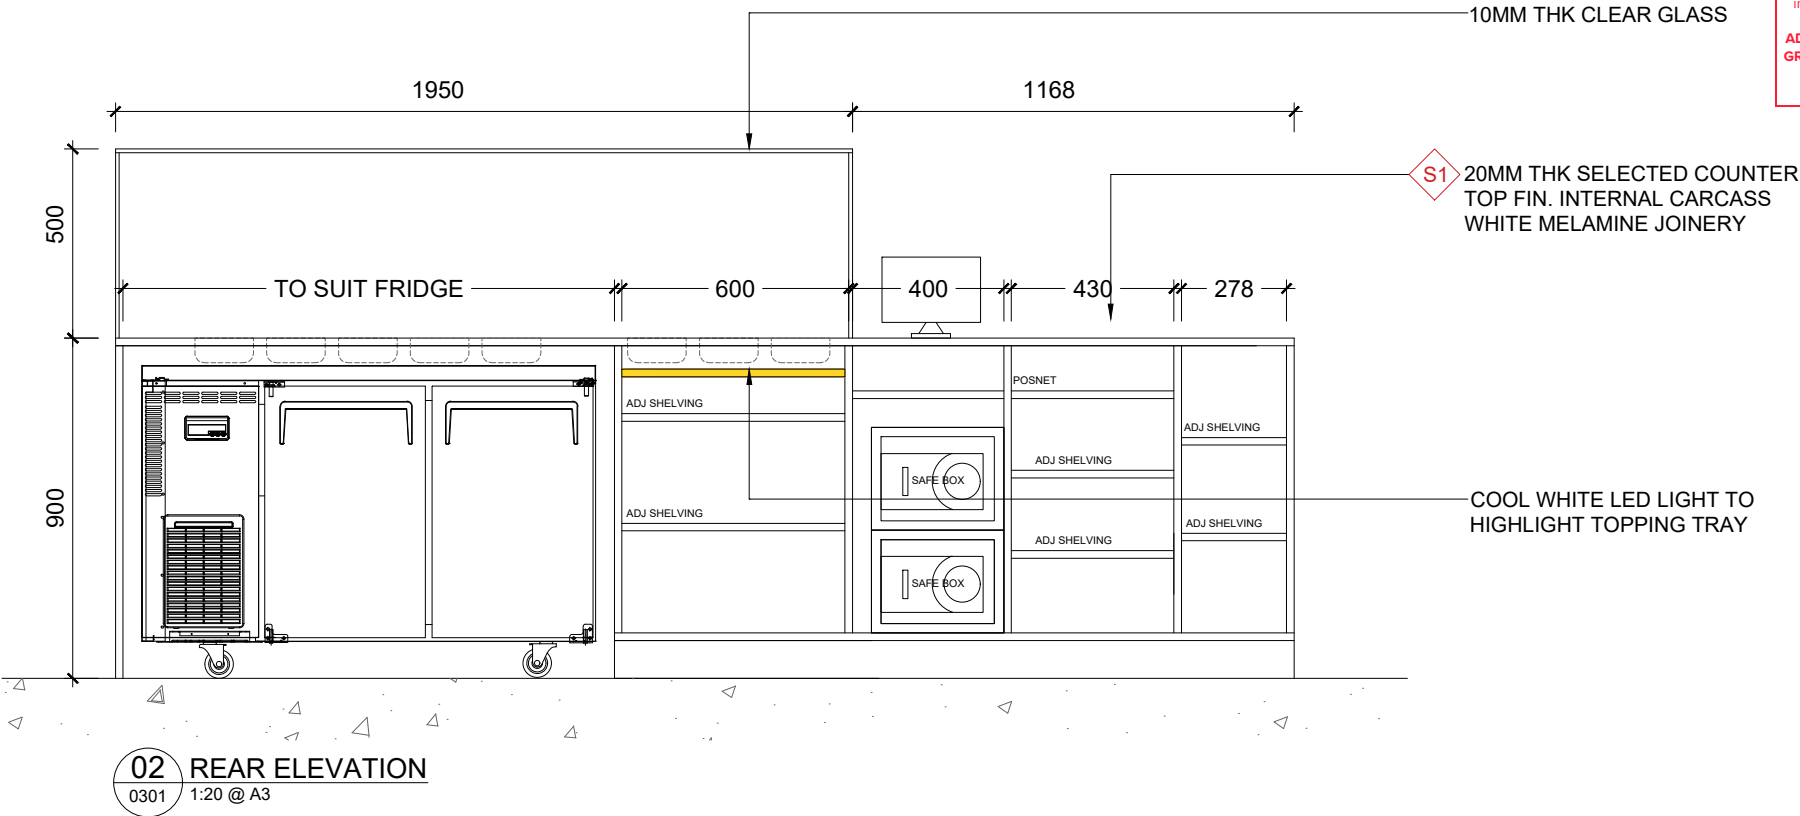

<div></div> <div>suite 42, Level 7, 591 George St, Sydney P (+61 2) 8068 1755 F (+61 2) 9264 8787 joel@liteco.com.au</div>	CLIENT YOGURTBERRY	<div>NOTES</div> <ul style="list-style-type: none">• All drawings to be read in conjunction with all engineers documentation and specification.• Contractor to ensure all new building works, new fittings and fixtures are installed to the current BCA, Australian Standards and Work Cover Regulations.• The Contractor shall use figured dimensions in preference to scaled dimensions. All dimensions shall be verified on site by the Contractors prior to commencing any work or preparing shop drawings.• All materials are to be used in accordance with manufacturer's specifications and instructions, and to comply with relevant Australian Standards.• Partition set-out to be approved by Project Manager on-site prior to construction.• COPYRIGHT These drawings and the designs are the property of Liteco project and must not be used, retained or copied without written permission of Liteco project.	D	11.09.2020	JC	DESIGN APPROVAL	TITLE COUNTER ELEVATION	DRAWING NO. 0301		
	PROJECT WESTFIELD WARRINGAH MALL KIOSK 25K1		C	02.09.2020	JC	DESIGN APPROVAL		SCALE 1:20 @ A3		
			B	24.08.2020	JC	DESIGN APPROVAL		CHECKED JC		
			A	29.05.2020	JC	DESIGN APPROVAL	ISSUE D			
			ISSUE	DATE	INITIALS	REVISION DETAIL	CLIENT APPROVAL			


NOTE:
JOINERY DRAWINGS SUBJECT TO SHOPDRAWINGS APPROVAL

BUILDER TO ENSURE STRUCTURAL INTEGRITY OF JOINERY

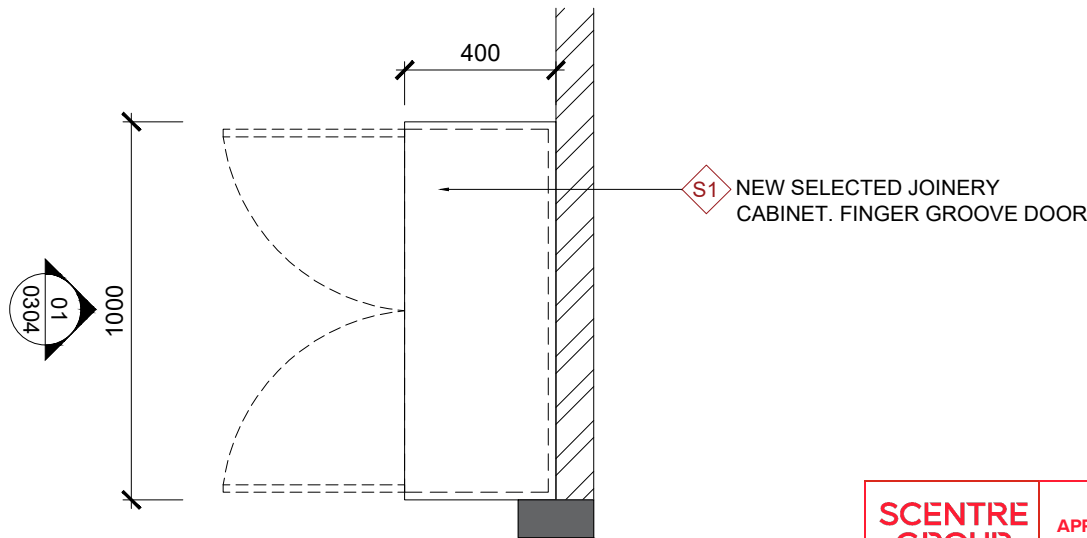


01 PLAN
0304 1:20 @ A3

SCENTRE GROUP		APPROVED DESIGN CONCEPT	
DATE:	17/09/2020	VERSION: 2	
WESTFIELD:	Warringah Mall		
SHOP:	25K1		
RETAIL DESIGN MANAGER:	Lana Munro		
Consent of the concept is granted to the lessee for the shopfront, shop layout and signage shown in these plans. Scentre Group notations including comments and handwritten changes must be complied with.			
ENGINEER'S CERTIFICATE REQUIRED TO VERIFY STRUCTURAL ADEQUACY. SHOPFITTERS MUST KEEP A COPY OF THESE SCENTRE GROUP STAMPED DRAWINGS ON SITE AT ALL TIMES. (DESTROY ALL PREVIOUS ISSUES AND ALL UNSTAMPED DRAWINGS)			

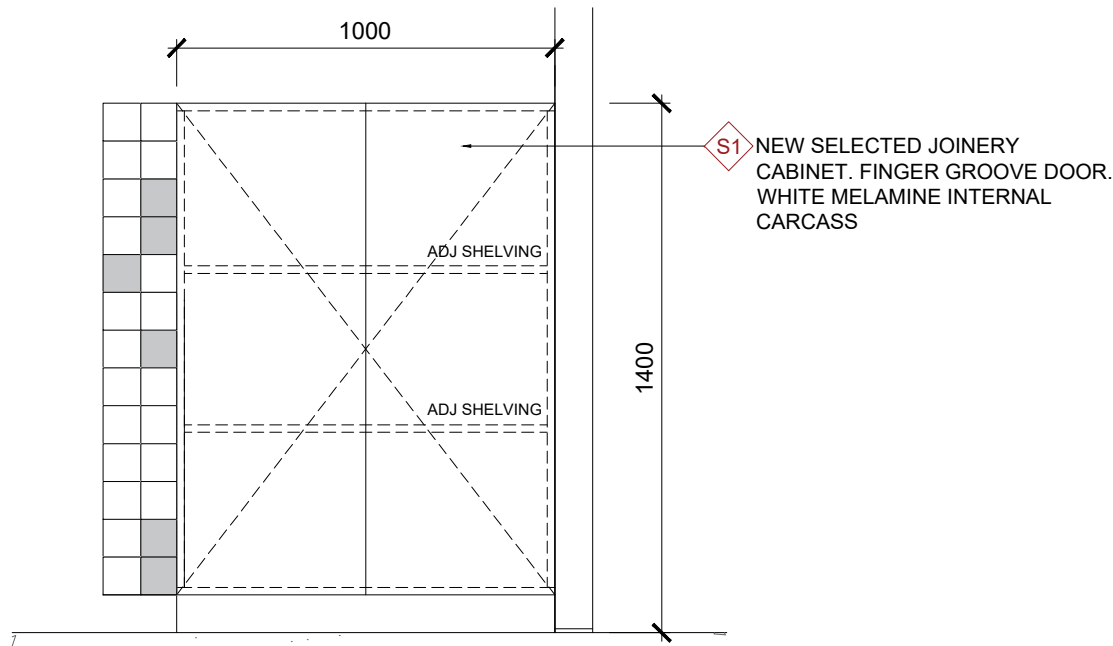

02 ELEVATION
0304 1:20 @ A3

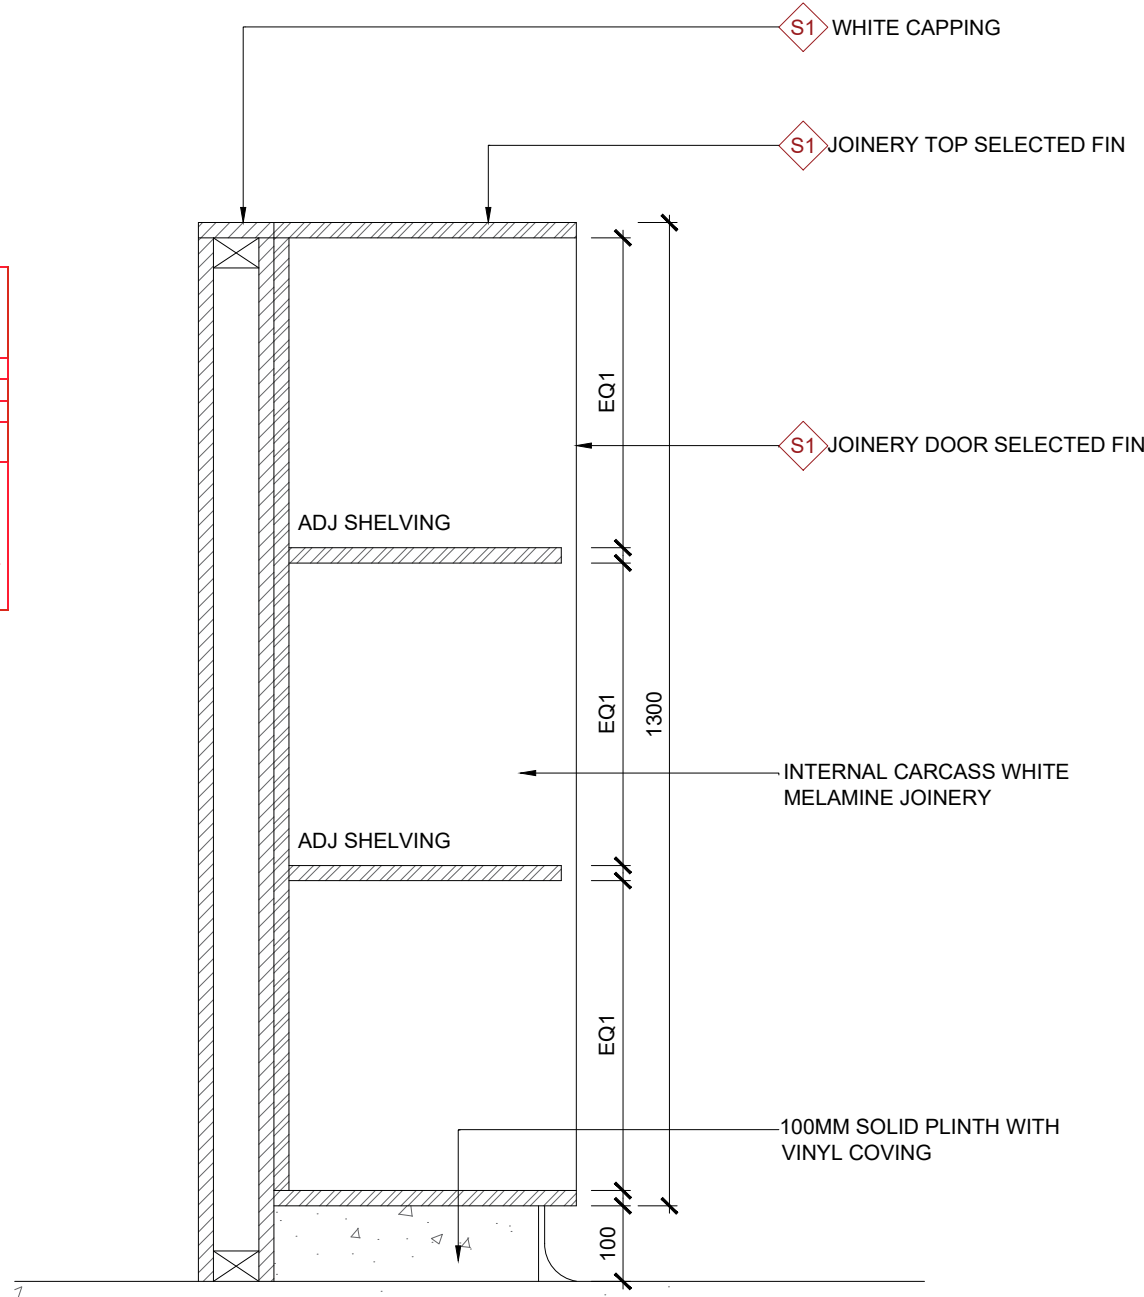

03 SECTION
0304 1:10 @ A3

 suite 42, Level 7, 591 George St, Sydney P (+61 2) 8068 1755 F (+61 2) 9264 8787 joel@liteco.com.au	CLIENT YOGURTBERRY	NOTES <ul style="list-style-type: none">All drawings to be read in conjunction with all engineers documentation and specification.Contractor to ensure all new building works, new fittings and fixtures are installed to the current BCA, Australian Standards and Work Cover Regulations.The Contractor shall use figured dimensions in preference to scaled dimensions. All dimensions shall be verified on site by the Contractors prior to commencing any work or preparing shop drawings.All materials are to be used in accordance with manufacturer's specifications and instructions, and to comply with relevant Australian Standards.Partition set-out to be approved by Project Manager on-site prior to construction.COPYRIGHT These drawings and the designs are the property of Liteco project and must not be used, retained or copied without written permission of Liteco project.				TITLE WALL CABINET JOINERY	DRAWING NO. 0304
	PROJECT WESTFIELD WARRINGAH MALL KIOSK 25K1		C	02.09.2020	JC	DESIGN APPROVAL	SCALE 1:20 @ A3
			B	24.08.2020	JC	DESIGN APPROVAL	CHECKED JC
			A	29.05.2020	JC	DESIGN APPROVAL	ISSUE C
			ISSUE	DATE	INITIALS	REVISION DETAIL	CLIENT APPROVAL



LOCATION:

FRONT COUNTER FASCIA.

TO BE CONFIRMED ON SITE BY SIGNAGE CONTRACTOR TO ENSURE ALL CABLING ARE CONCEALED

BUILDER TO ENSURE CONCEALED FIXINGS, CABLES AND SCREW REQUIRED

SCENTRE GROUP		APPROVED DESIGN CONCEPT	
DATE:	17/09/2020	VERSION: 2	
WESTFIELD:	Warringah Mall		
SHOP:	25K1		
RETAIL DESIGN MANAGER:	Lana Munro		
<p>Consent of the concept is granted to the lessee for the shopfront, shop layout and signage shown in these plans. Scentre Group notations including comments and handwritten changes must be complied with.</p> <p>ENGINEER'S CERTIFICATE REQUIRED TO VERIFY STRUCTURAL ADEQUACY. SHOPFITTERS MUST KEEP A COPY OF THESE SCENTRE GROUP STAMPED DRAWINGS ON SITE AT ALL TIMES. (DESTROY ALL PREVIOUS ISSUES AND ALL UNSTAMPED DRAWINGS)</p>			




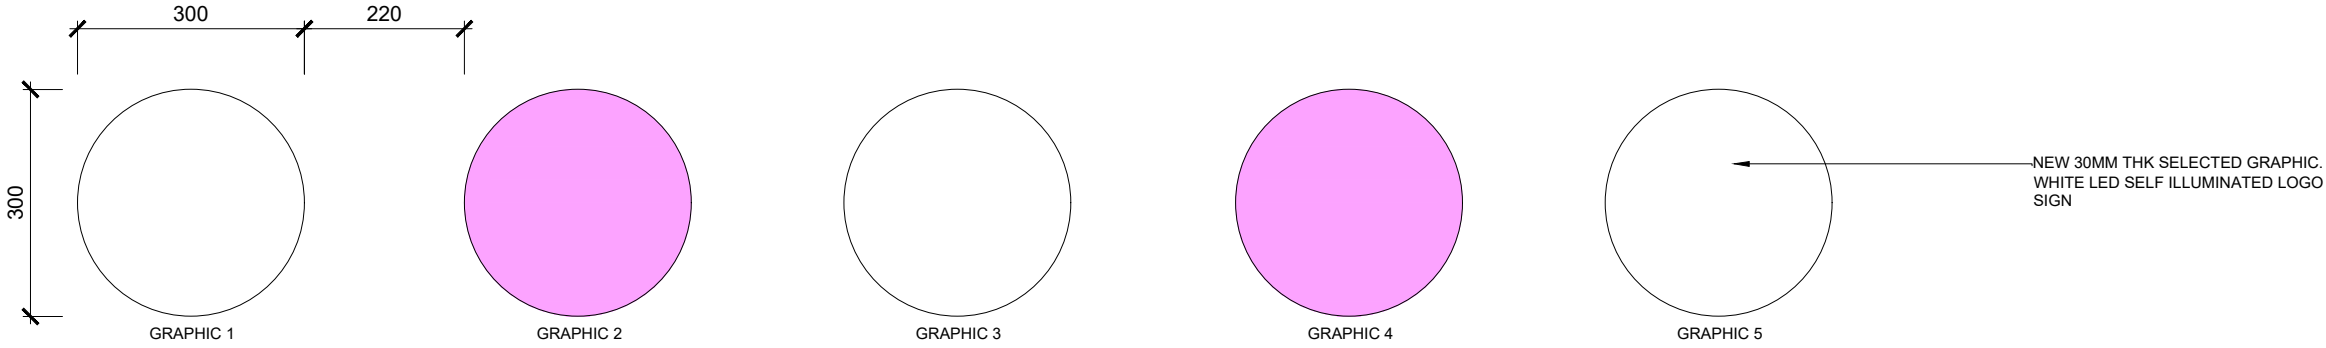
LOCATION:

REAR WALL.

TO BE CONFIRMED ON SITE BY SIGNAGE CONTRACTOR TO ENSURE ALL CABLING ARE CONCEALED

BUILDER TO ENSURE CONCEALED FIXINGS, CABLES AND SCREW REQUIRED

<div><p>suite 42, Level 7, 591 George St, Sydney P (+61 2) 8068 1755 F (+61 2) 9264 8787 joel@liteco.com.au</p></div>	CLIENT YOGURTBERRY	NOTES <ul style="list-style-type: none">All drawings to be read in conjunction with all engineers documentation and specification.Contractor to ensure all new building works, new fittings and fixtures are installed to the current BCA, Australian Standards and Work Cover Regulations.The Contractor shall use figured dimensions in preference to scaled dimensions. All dimensions shall be verified on site by the Contractors prior to commencing any work or preparing shop drawings.All materials are to be used in accordance with manufacturer's specifications and instructions, and to comply with relevant Australian Standards.Partition set-out to be approved by Project Manager on-site prior to construction.COPYRIGHT These drawings and the designs are the property of Liteco project and must not be used, retained or copied without written permission of Liteco project.				TITLE	YOGURTBERRY SIGN	DRAWING NO. 0400	
	PROJECT WESTFIELD WARRINGAH MALL KIOSK 25K1		B	24.08.2020	JC	DESIGN APPROVAL		SCALE	NA @ A3
			A	29.05.2020	JC	DESIGN APPROVAL		CHECKED	JC
			ISSUE	DATE	INITIALS	REVISION DETAIL	CLIENT APPROVAL	ISSUE	B




LOCATION:

REAR WALL.

TO BE CONFIRMED ON SITE BY SIGNAGE CONTRACTOR TO ENSURE ALL CABLING ARE CONCEALED



SCENTRE GROUP		APPROVED DESIGN CONCEPT	
DATE:	17/09/2020	VERSION: 2	
WESTFIELD:	Warringah Mall		
SHOP:	25K1		
RETAIL DESIGN MANAGER:	Lana Munro		
Consent of the concept is granted to the lessee for the shopfront, shop layout and signage shown in these plans. Scentre Group notations including comments and handwritten changes must be complied with.			
ENGINEER'S CERTIFICATE REQUIRED TO VERIFY STRUCTURAL ADEQUACY. SHOPFITTERS MUST KEEP A COPY OF THESE SCENTRE GROUP STAMPED DRAWINGS ON SITE AT ALL TIMES. (DESTROY ALL PREVIOUS ISSUES AND ALL UNSTAMPED DRAWINGS)			

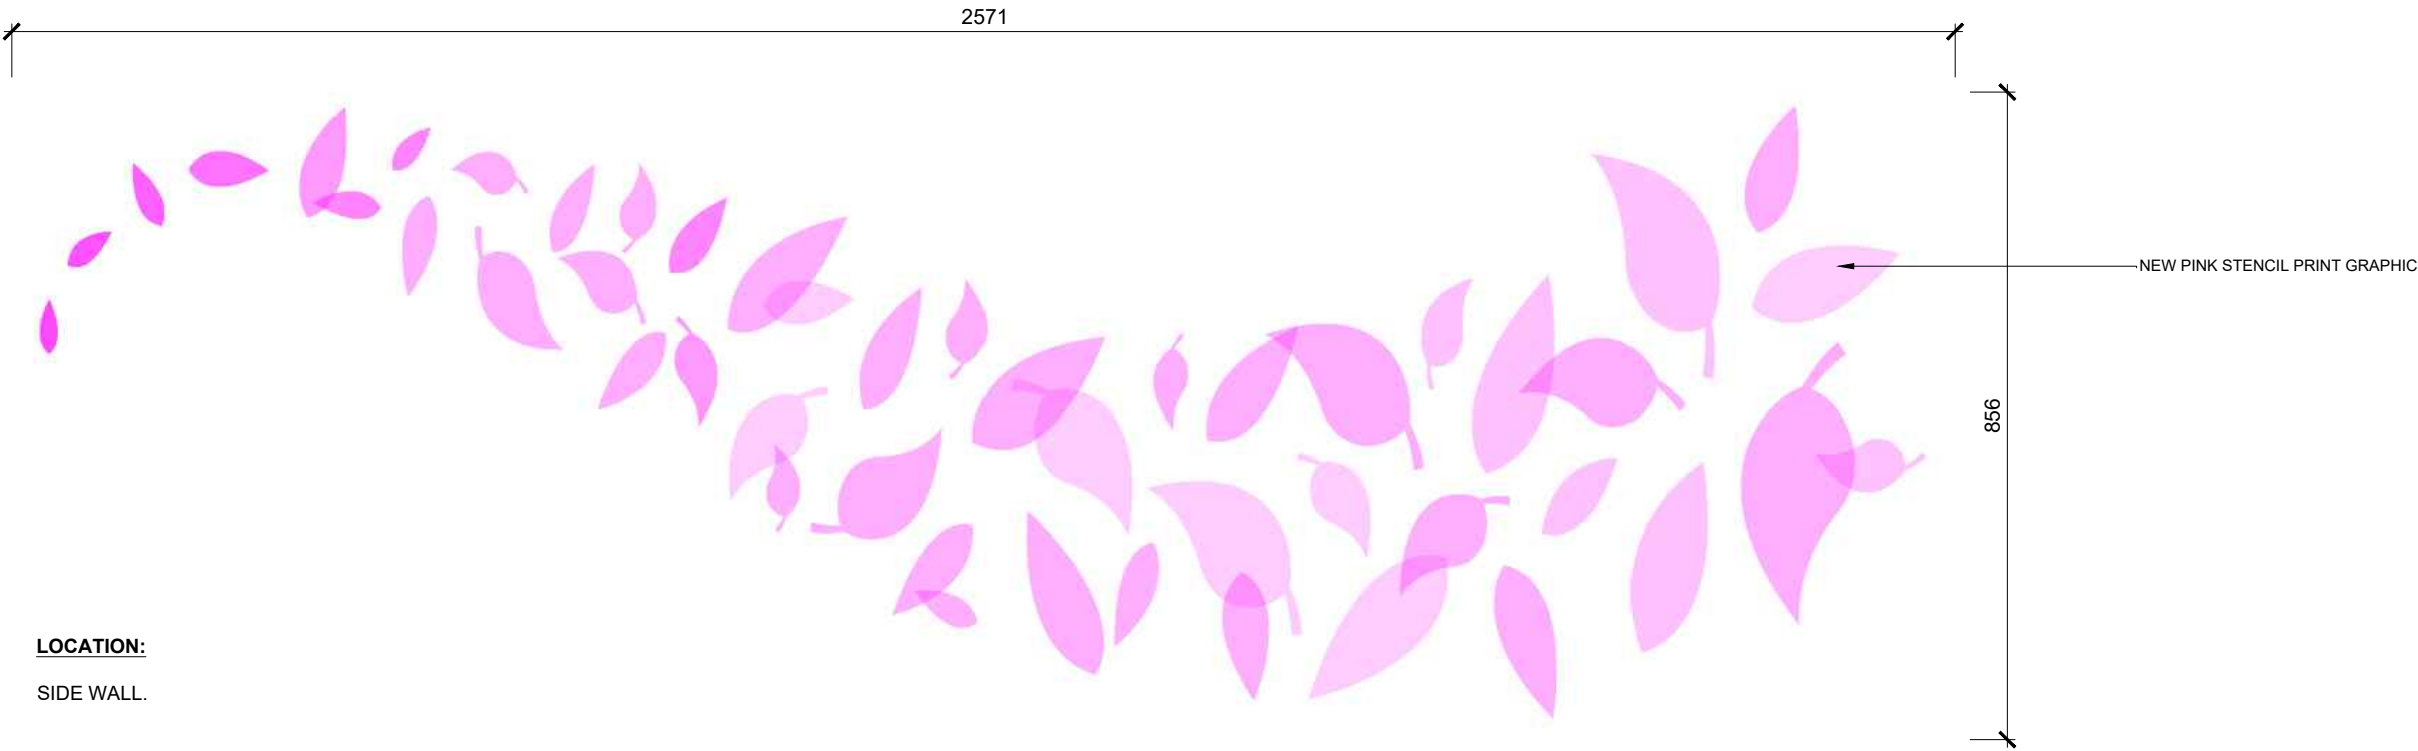



LOCATION:


SIDE WALL.


 suite 42, Level 7, 591 George St, Sydney P (+61 2) 8068 1755 F (+61 2) 9264 8787 joel@liteco.com.au	CLIENT YOGURTBERRY	NOTES <ul style="list-style-type: none">All drawings to be read in conjunction with all engineers documentation and specification.Contractor to ensure all new building works, new fittings and fixtures are installed to the current BCA, Australian Standards and Work Cover Regulations.The Contractor shall use figured dimensions in preference to scaled dimensions. All dimensions shall be verified on site by the Contractors prior to commencing any work or preparing shop drawings.All materials are to be used in accordance with manufacturer's specifications and instructions, and to comply with relevant Australian Standards.Partition set-out to be approved by Project Manager on-site prior to construction.COPYRIGHT These drawings and the designs are the property of Liteco project and must not be used, retained or copied without written permission of Liteco project.					TITLE GRAPHIC SIGN	DRAWING NO. 0401
	PROJECT WESTFIELD WARRINGAH MALL KIOSK 25K1							SCALE NA @ A3
			A	29.05.2020	JC	DESIGN APPROVAL	DRAWN BY JC	CHECKED JC
			ISSUE	DATE	INITIALS	REVISION DETAIL	CLIENT APPROVAL	ISSUE A

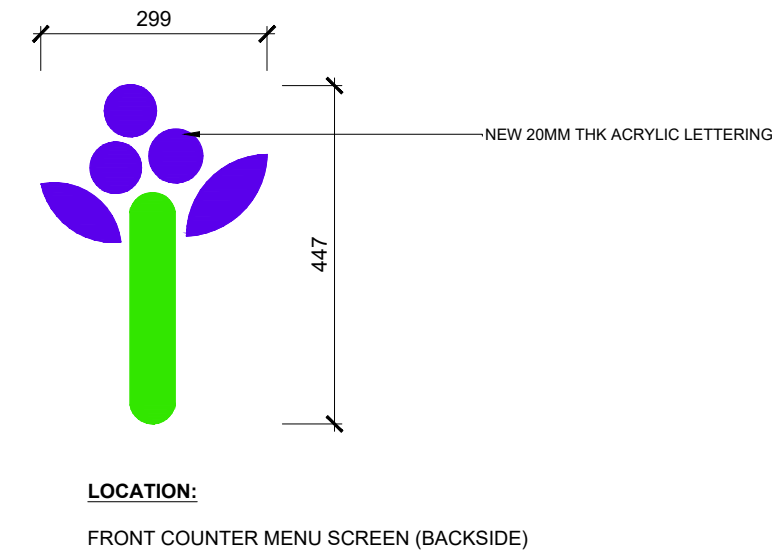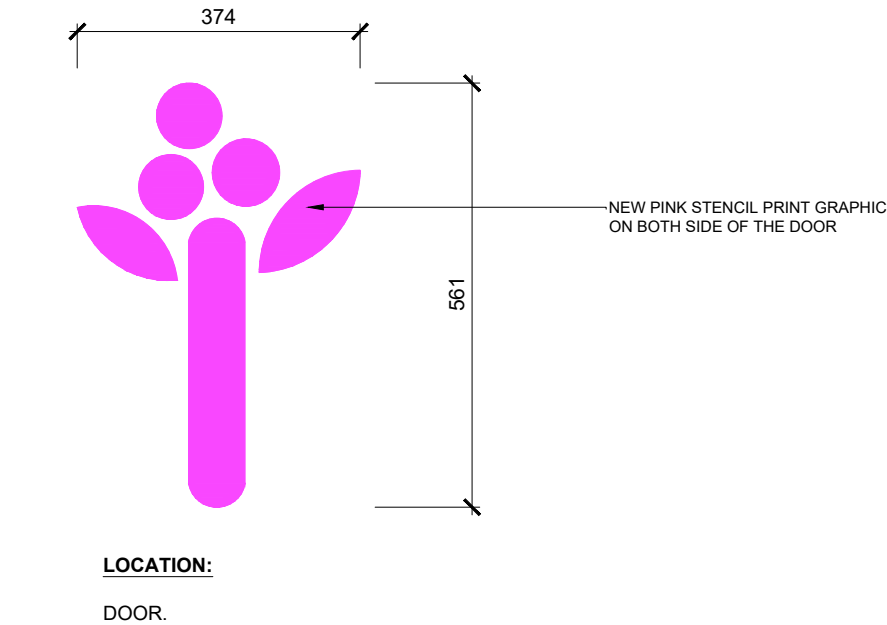

SCENTRE GROUP		APPROVED DESIGN CONCEPT	
DATE:	17/09/2020	VERSION: 2	
WESTFIELD:	Warringah Mall		
SHOP:	25K1		
RETAIL DESIGN MANAGER:	Lana Munro		
<p>Consent of the concept is granted to the lessee for the shopfront, shop layout and signage shown in these plans. Scentre Group notations including comments and handwritten changes must be complied with.</p> <p>ENGINEER'S CERTIFICATE REQUIRED TO VERIFY STRUCTURAL ADEQUACY. SHOPFITTERS MUST KEEP A COPY OF THESE SCENTRE GROUP STAMPED DRAWINGS ON SITE AT ALL TIMES. (DESTROY ALL PREVIOUS ISSUES AND ALL UNSTAMPED DRAWINGS)</p>			

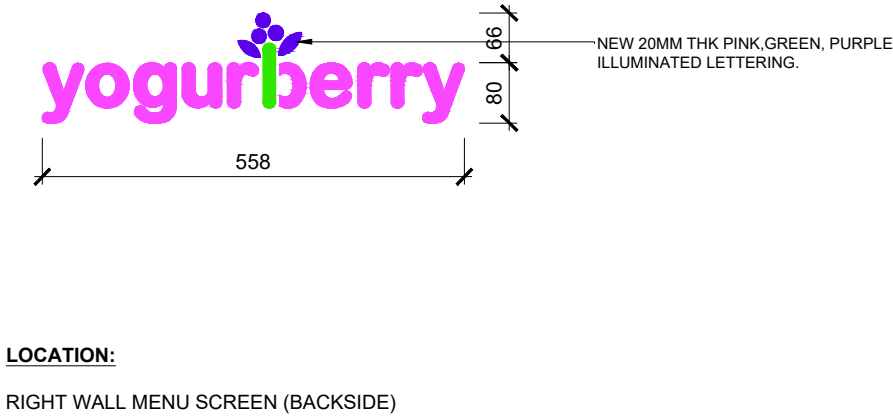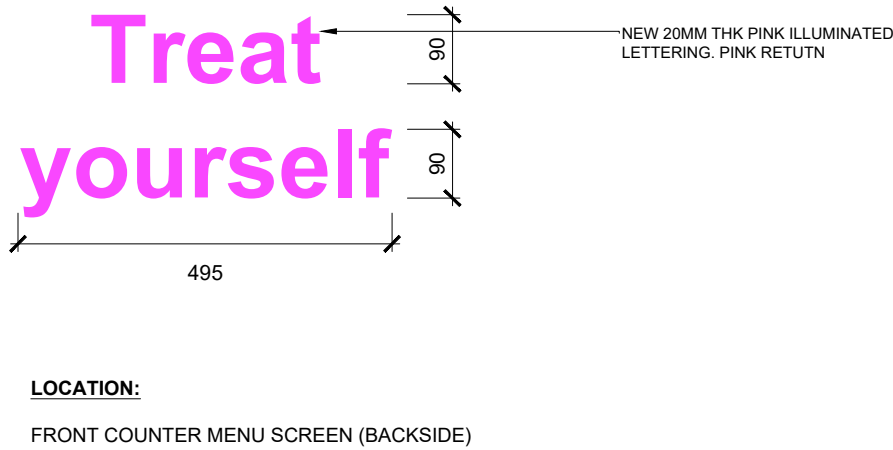

 suite 42, Level 7, 591 George St, Sydney P (+61 2) 8068 1755 F (+61 2) 9264 8787 joel@liteco.com.au	CLIENT YOGURTBERRY	NOTES <ul style="list-style-type: none">All drawings to be read in conjunction with all engineers documentation and specification.Contractor to ensure all new building works, new fittings and fixtures are installed to the current BCA, Australian Standards and Work Cover Regulations.The Contractor shall use figured dimensions in preference to scaled dimensions. All dimensions shall be verified on site by the Contractors prior to commencing any work or preparing shop drawings.All materials are to be used in accordance with manufacturer's specifications and instructions, and to comply with relevant Australian Standards.Partition set-out to be approved by Project Manager on-site prior to construction.COPYRIGHT These drawings and the designs are the property of Liteco project and must not be used, retained or copied without written permission of Liteco project.				TITLE GRAPHIC SIGN 2	DRAWING NO. 0402	
	PROJECT WESTFIELD WARRINGAH MALL KIOSK 25K1						SCALE NA @ A3	
			B	11.09.2020	JC	DESIGN APPROVAL		
			A	29.05.2020	JC	DESIGN APPROVAL	DRAWN BY JC	CHECKED JC
			ISSUE	DATE	INITIALS	REVISION DETAIL	CLIENT APPROVAL	ISSUE B

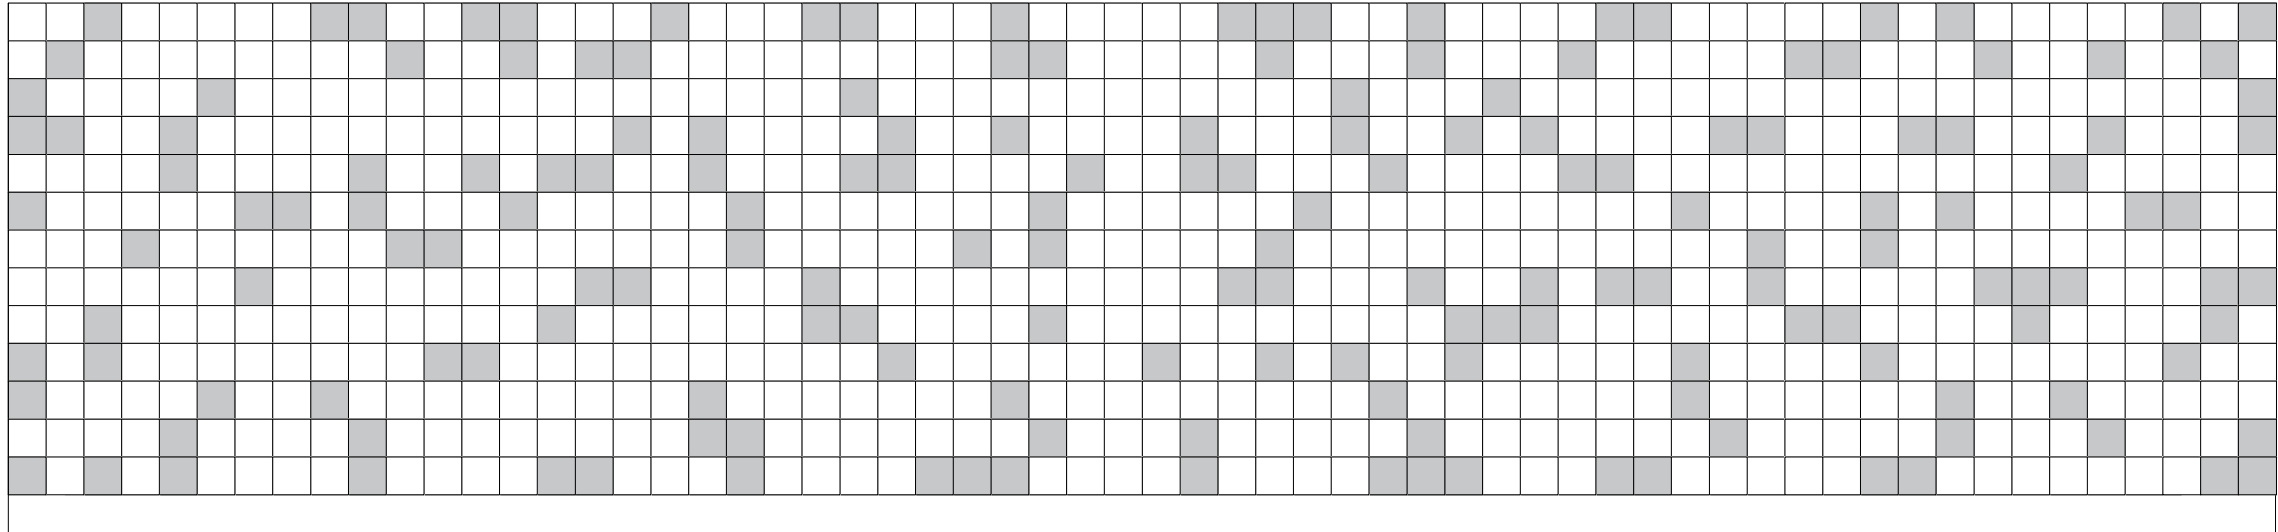


LOCATION:
REAR EXTERNAL WALL

SCENTRE GROUP

APPROVED DESIGN CONCEPT


DATE:	17/09/2020	VERSION: 2
WESTFIELD:	Warringah Mall	
SHOP:	25K1	
RETAIL DESIGN MANAGER:	Lana Munro	

Consent of the concept is granted to the lessee for the shopfront, shop layout and signage shown in these plans. Scentre Group notations including comments and handwritten changes must be complied with.
ENGINEER'S CERTIFICATE REQUIRED TO VERIFY STRUCTURAL ADEQUACY. SHOPFITTERS MUST KEEP A COPY OF THESE SCENTRE GROUP STAMPED DRAWINGS ON SITE AT ALL TIMES. (DESTROY ALL PREVIOUS ISSUES AND ALL UNSTAMPED DRAWINGS)

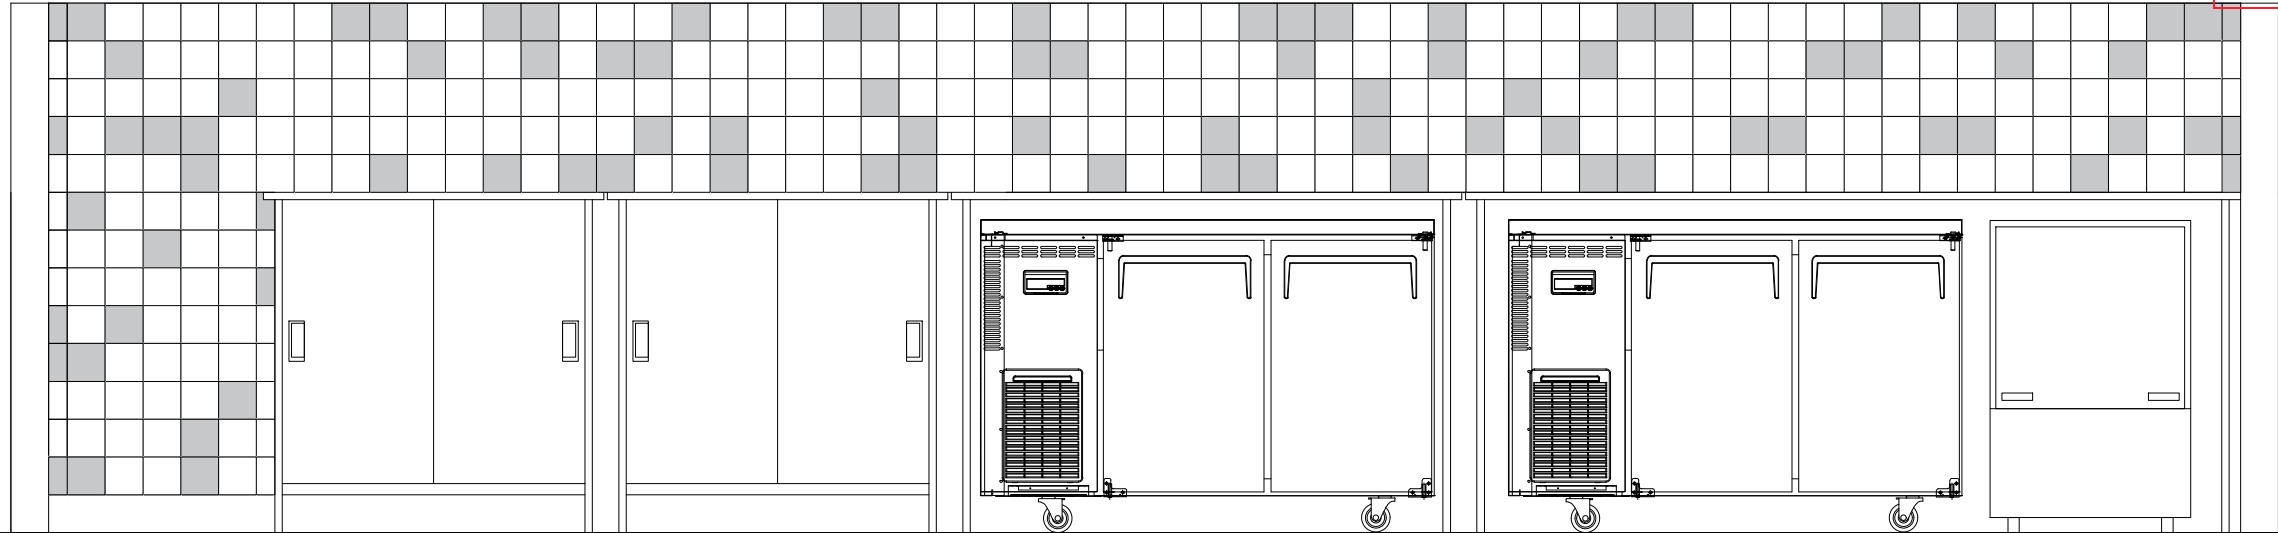


LOCATION:
REAR INTERNAL WALL


<div><div><div>LITECO</div><div>STUDIO</div></div><div><div>suite 42, Level 7, 591 George St, Sydney</div><div>P (+61 2) 8068 1755</div><div>F (+61 2) 9264 8787</div><div>joel@liteco.com.au</div></div></div>	CLIENT	<div>NOTES</div> <ul style="list-style-type: none">All drawings to be read in conjunction with all engineers documentation and specification.Contractor to ensure all new building works, new fittings and fixtures are installed to the current BCA, Australian Standards and Work Cover Regulations.The Contractor shall use figured dimensions in preference to scaled dimensions. All dimensions shall be verified on site by the Contractors prior to commencing any work or preparing shop drawings.All materials are to be used in accordance with manufacturer's specifications and instructions, and to comply with relevant Australian Standards.Partition set-out to be approved by Project Manager on-site prior to construction.COPYRIGHT These drawings and the designs are the property of Liteco project and must not be used, retained or copied without written permission of Liteco project.				TITLE	DRAWING NO.
	YOGURTBERRY		C	11.09.2020	JC	DESIGN APPROVAL	
	PROJECT		B	27.08.2020	JC	DESIGN APPROVAL	SCALE
	WESTFIELD WARRINGAH MALL KIOSK 25K1		A	29.05.2020	JC	DESIGN APPROVAL	CHECKED
			ISSUE	DATE	INITIALS	REVISION DETAIL	ISSUE
						CLIENT APPROVAL	0403
							NA @ A3
							JC
							C

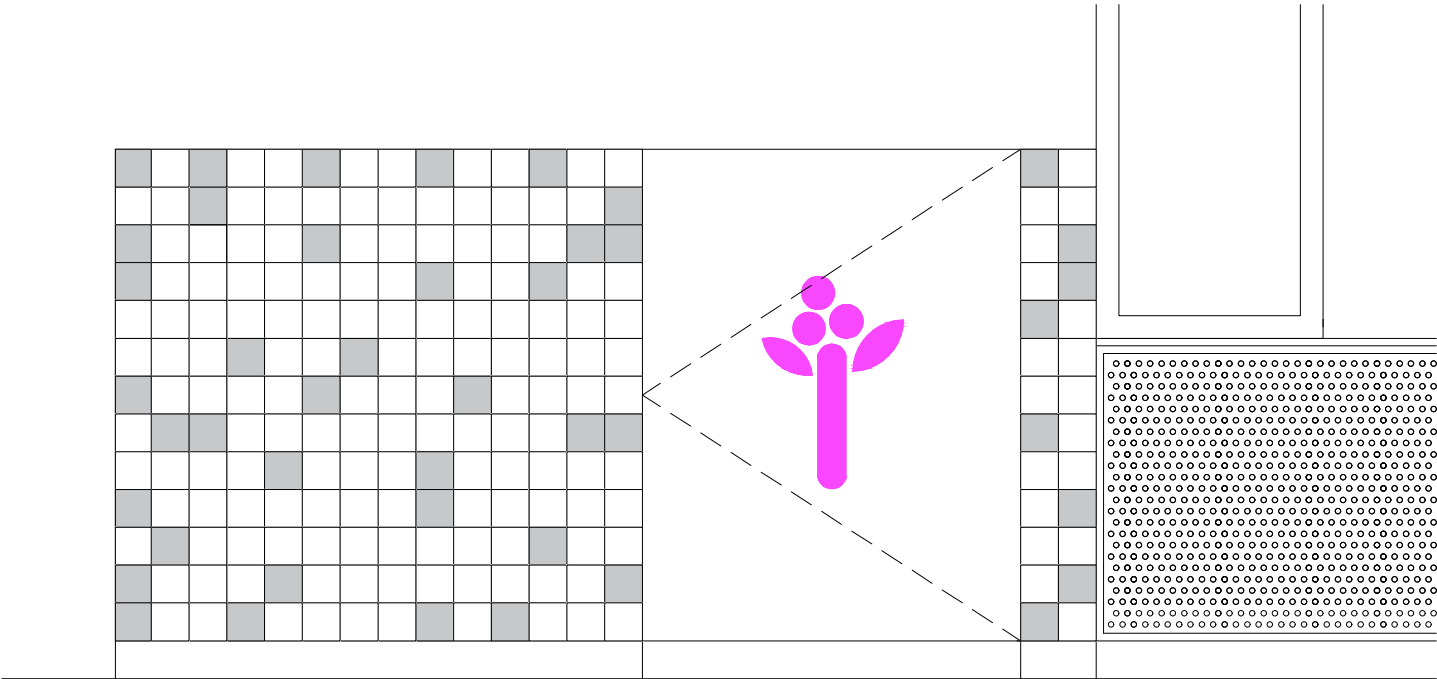

LOCATION:
LEFT EXTERNAL WALL

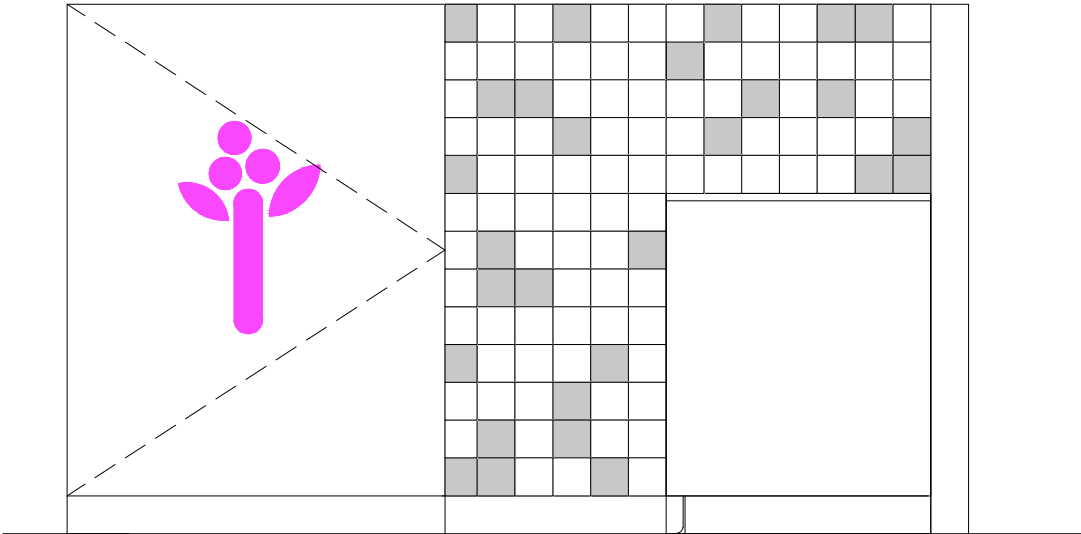


LOCATION:
LEFT INTERNAL WALL

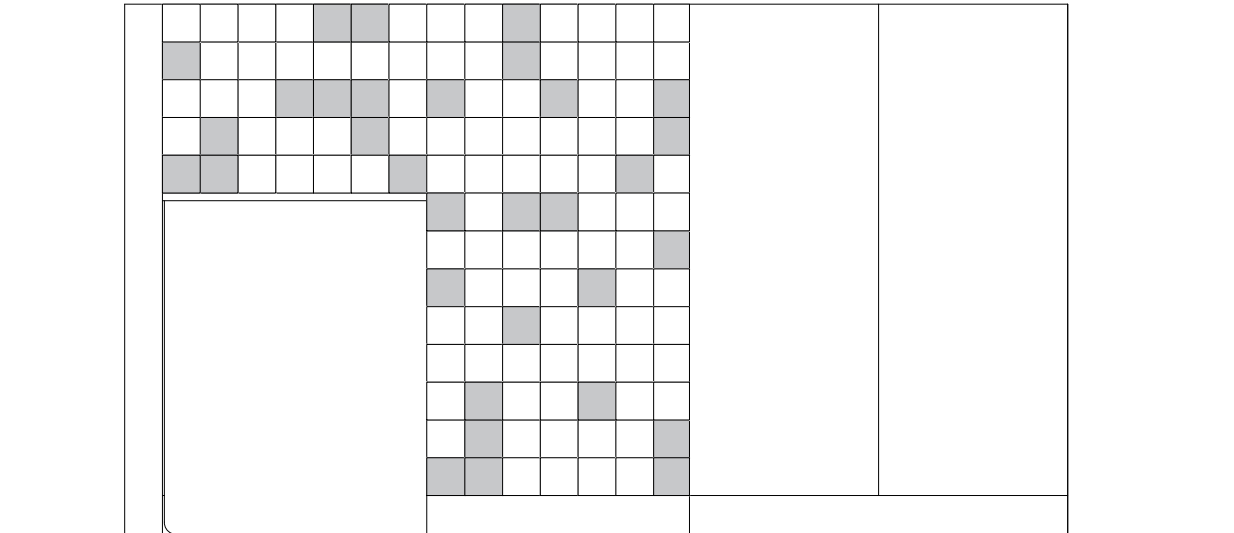

LOCATION:
RIGHT INTERNAL WALL

SCENTRE GROUP		APPROVED DESIGN CONCEPT	
DATE:	17/09/2020	VERSION:	2
WESTFIELD:	Warringah Mall		
SHOP:	25K1		
RETAIL DESIGN	Lana Munro		
MANAGER:	Lana Munro		
Consent of the concept is granted to the lessee for the shopfront, shop layout and signage shown in these plans. Scentre Group notations including comments and handwritten changes must be complied with.			
ENGINEER'S CERTIFICATE REQUIRED TO VERIFY STRUCTURAL ADEQUACY. SHOPFITTERS MUST KEEP A COPY OF THESE SCENTRE GROUP STAMPED DRAWINGS ON SITE AT ALL TIMES. (DESTROY ALL PREVIOUS ISSUES AND ALL UNSTAMPED DRAWINGS)			

<div><p>suite 42, Level 7, 591 George St, Sydney P (+61 2) 8068 1755 F (+61 2) 9264 8787 joel@liteco.com.au</p></div>	CLIENT YOGURTBERRY	<div>NOTES</div> <ul style="list-style-type: none">All drawings to be read in conjunction with all engineers documentation and specification.Contractor to ensure all new building works, new fittings and fixtures are installed to the current BCA, Australian Standards and Work Cover Regulations.The Contractor shall use figured dimensions in preference to scaled dimensions. All dimensions shall be verified on site by the Contractors prior to commencing any work or preparing shop drawings.All materials are to be used in accordance with manufacturer's specifications and instructions, and to comply with relevant Australian Standards.Partition set-out to be approved by Project Manager on-site prior to construction.COPYRIGHT These drawings and the designs are the property of Liteco project and must not be used, retained or copied without written permission of Liteco project.				TITLE	DRAWING NO.
	PROJECT WESTFIELD WARRINGAH MALL KIOSK 25K1					TILES ARRANGEMENT 2	0404
			B	11.09.2020	JC	DESIGN APPROVAL	SCALE NA @ A3
			A	29.05.2020	JC	DESIGN APPROVAL	CHECKED JC
			ISSUE	DATE	INITIALS	REVISION DETAIL	CLIENT APPROVAL ISSUE B